


Ref: Logan Co. Recorder's Office
Plat Book B, Vol. 2, page 43
Deed Book, Vol. 288, page 248

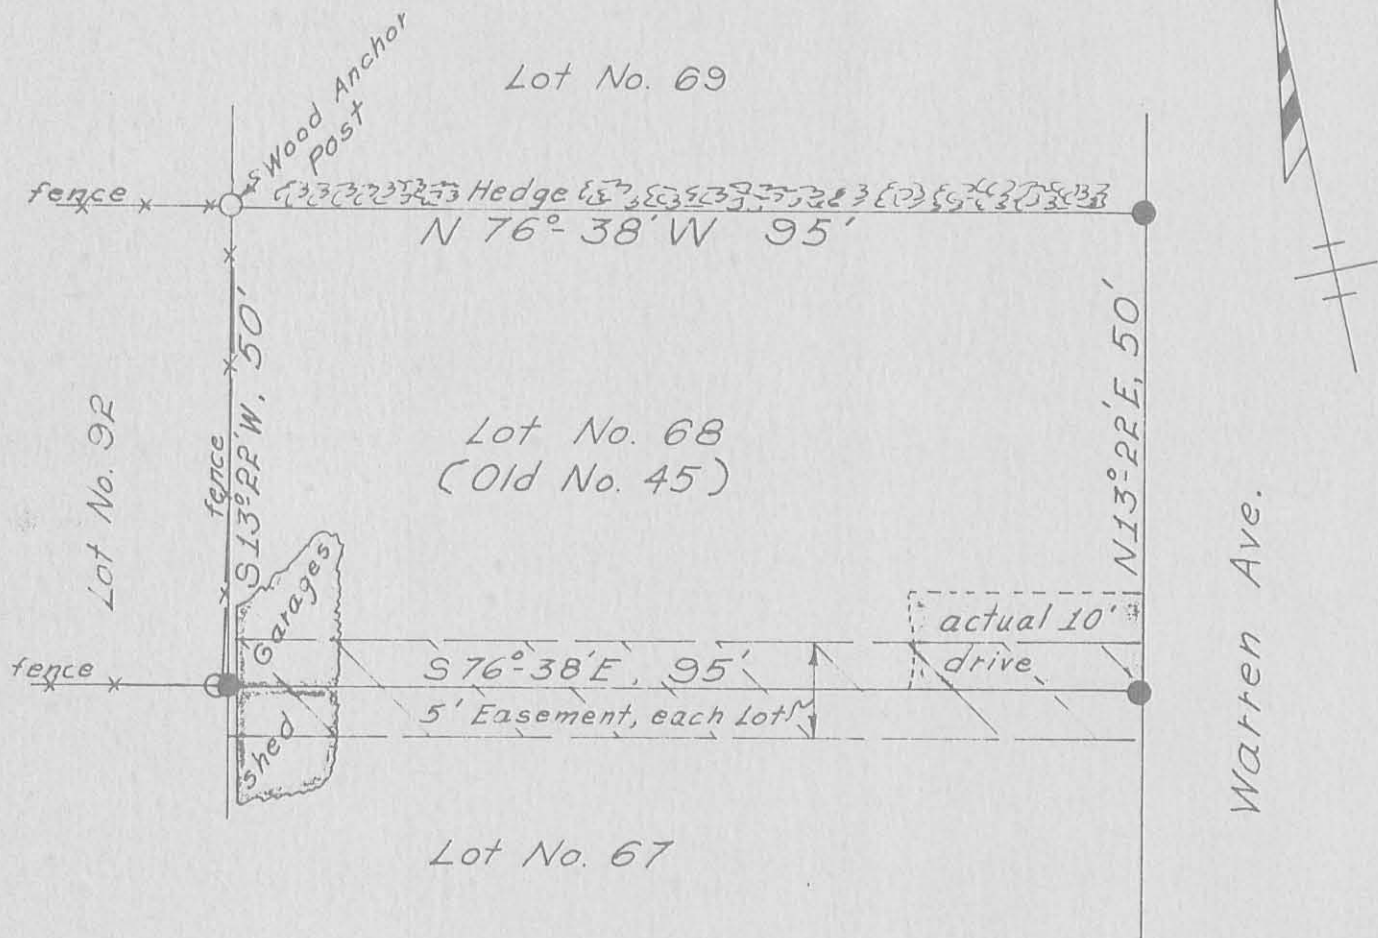

CAIN PARK
Village of Russells Point
Washington Township
Logan County, Ohio

● = Iron pin set
Scale: 1" = 20'

Chester R. Kurtz
Chester R. Kurtz, P.E.
Registered Surveyor
Ohio No. 4849

3689 IP

