


OK 9<sup>th</sup>

PT. LOT 29 and 30  
RUSSELLS POINT  
April 12, 1969

The following described real estate situated in the Village of Russells Point, Washington Township, Logan County, Ohio and being part of Lots 29 and 30 as shown on Logan County Recorders Plat Book B, Volume 2, Page 119 and more particularly described as follows:

Beginning at a nail in concrete walk at the intersection of the north line of State Route 366 and the east line of Burkhart Avenue, said nail being the southwest corner of said lot No.30; thence with the east line of Burkhart Avenue North 76.00 feet to an iron pipe, passing the northwest corner of lot 30 at 59.14 feet; thence S.83° 45'E. 61.70 feet to an iron pipe; thence S.8° 33'W. 80.20 feet to a chiseled cross on concrete walk in the north line of said S.R.366; thence with said north line N.78° 28'W. 50.42 feet to the place of beginning.

INDEXED ON MAP  
7565 1D

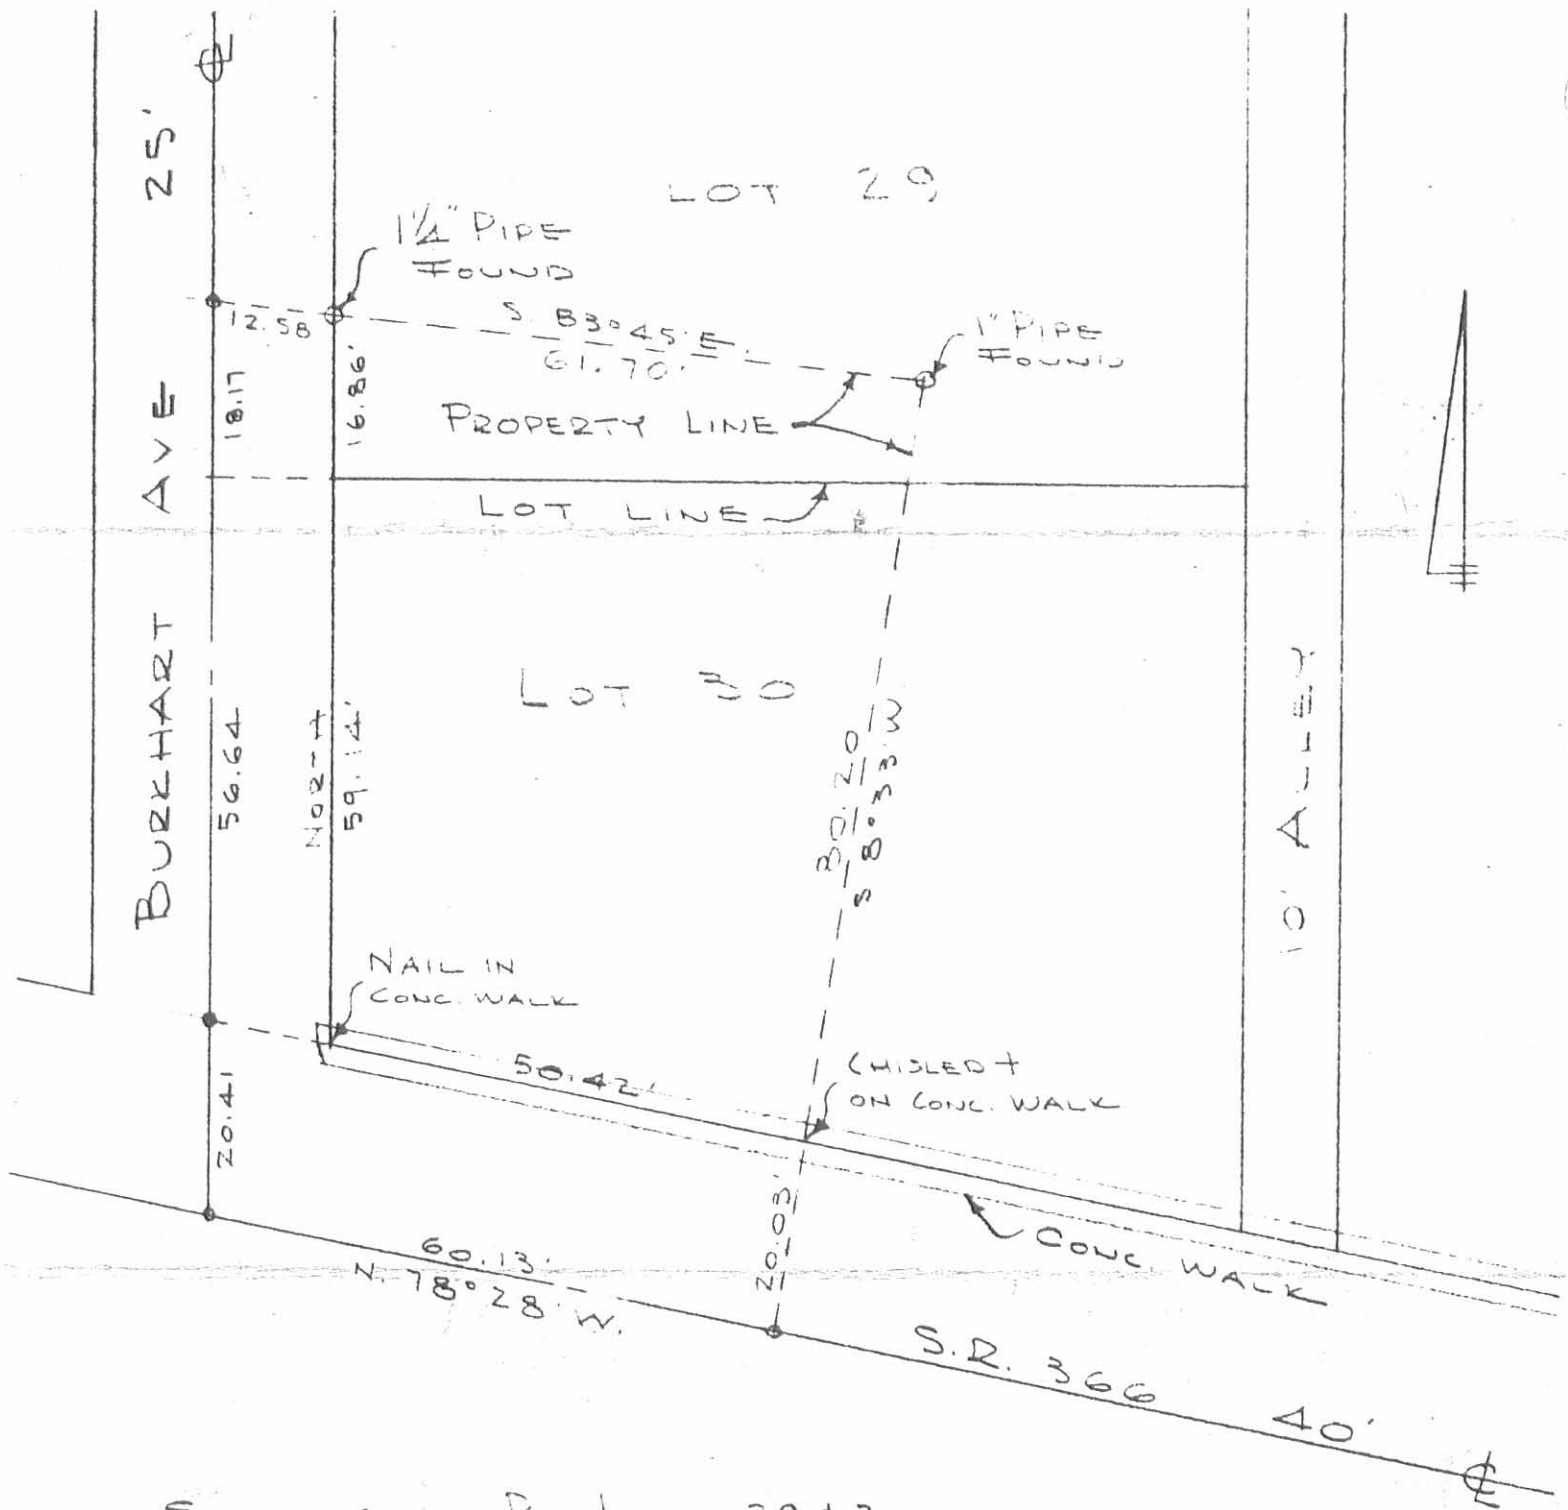

SURVEY OF Pt. LOTS 29 & 30  
 RUSSELLS POINT, OHIO  
 APRIL 12, 1969  
 SCALE 1" = 20'  
 O = P-K NAIL SET ON  $\Phi$

INDEXED ON MAP  
 7565 1P

DAN L. DODSON  
 REG. SURVEYOR 4270  
 DELAWARE, OHIO  
 FEB. 13/74