

● -5/8" x 30" Rebars Set.

Per. Par. No. 52-032-13-29-000.000

INDEXED ON MAP  
8016 1P



Survey of Lots 1060 thru 1065  
Village of Russells Point  
Washington Township  
Logan County, Ohio  
April 4, 1990


Scale: 1" = 40'

*Daniel E. Gilbert*  
Daniel E. Gilbert, P.S.  
Reg. Sur. No. 5402  
400 N. Park St.  
Bellefontaine, Ohio  
43311


REC'D 10-17-95 SWJ OK

LEGEND

- 3/4" IRON PIPE FOUND
- 5/8" IRON ROD FOUND

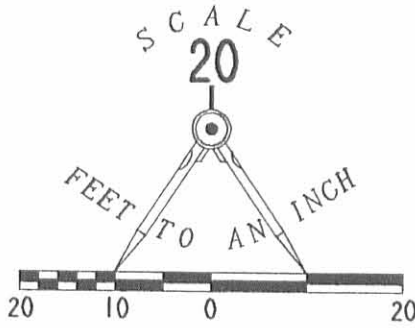

CLINE STREET (30')

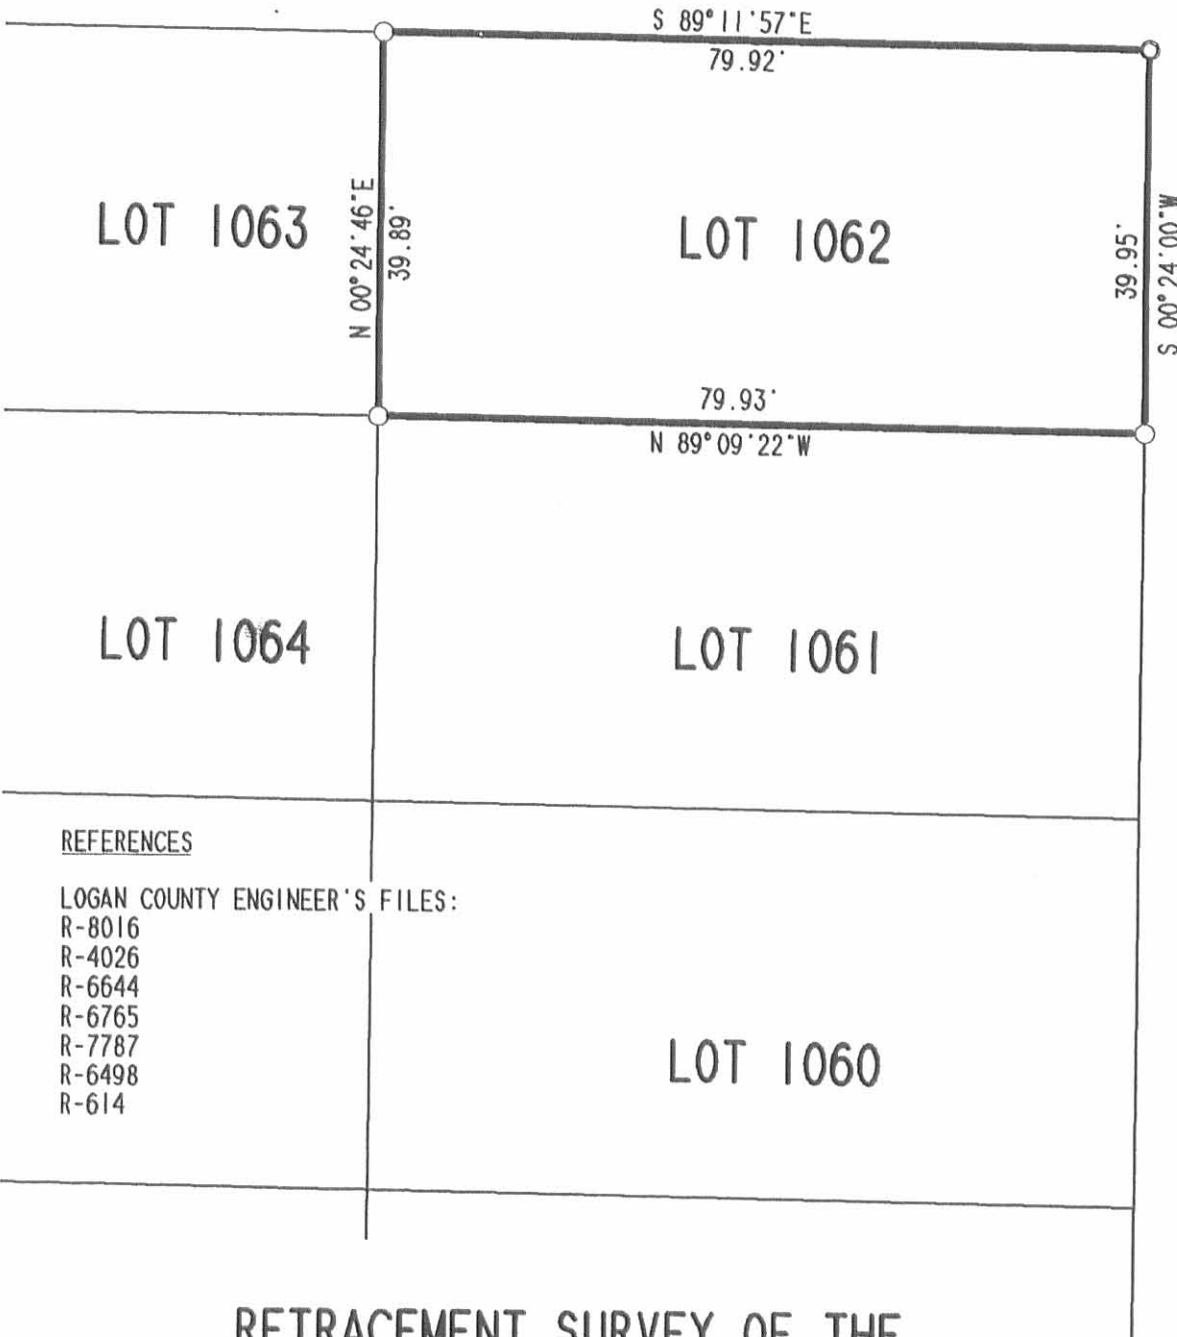

REFERENCES

- LOGAN COUNTY ENGINEER'S FILES:
- R-8016
  - R-4026
  - R-6644
  - R-6765
  - R-7787
  - R-6498
  - R-614

RETRACEMENT SURVEY OF THE  
 LOT NUMBER 1062  
 OF MORNING SIDE SUBDIVISION  
 PLAT CABINET A. SLIDE 240  
 VILLAGE OF RUSSELLS POINT  
 WASHINGTON TOWNSHIP  
 LOGAN COUNTY, OHIO

INDEXED ON MAP  
 8016 2P



SURVEYED BY:

JEFFREY I. LEE  
 PROFESSIONAL SURVEYOR 6359  
 OCTOBER 17, 1995

2 WORKING DAYS  
**BEFORE YOU DIG**  
 CALL TOLL FREE **800-362-2764**  
 OHIO UTILITIES PROTECTION SERVICE.

COPYRIGHT 1995 BY:  
**LEE SURVEYING & MAPPING CO.**  
 143 East Columbus Avenue  
 BELLEFONTAINE, OHIO 43311  
 (513) 593-7335

ORIGINAL STAMP IN GREEN

D 267 FARMER

L-2337-4