



Received 8-18-91

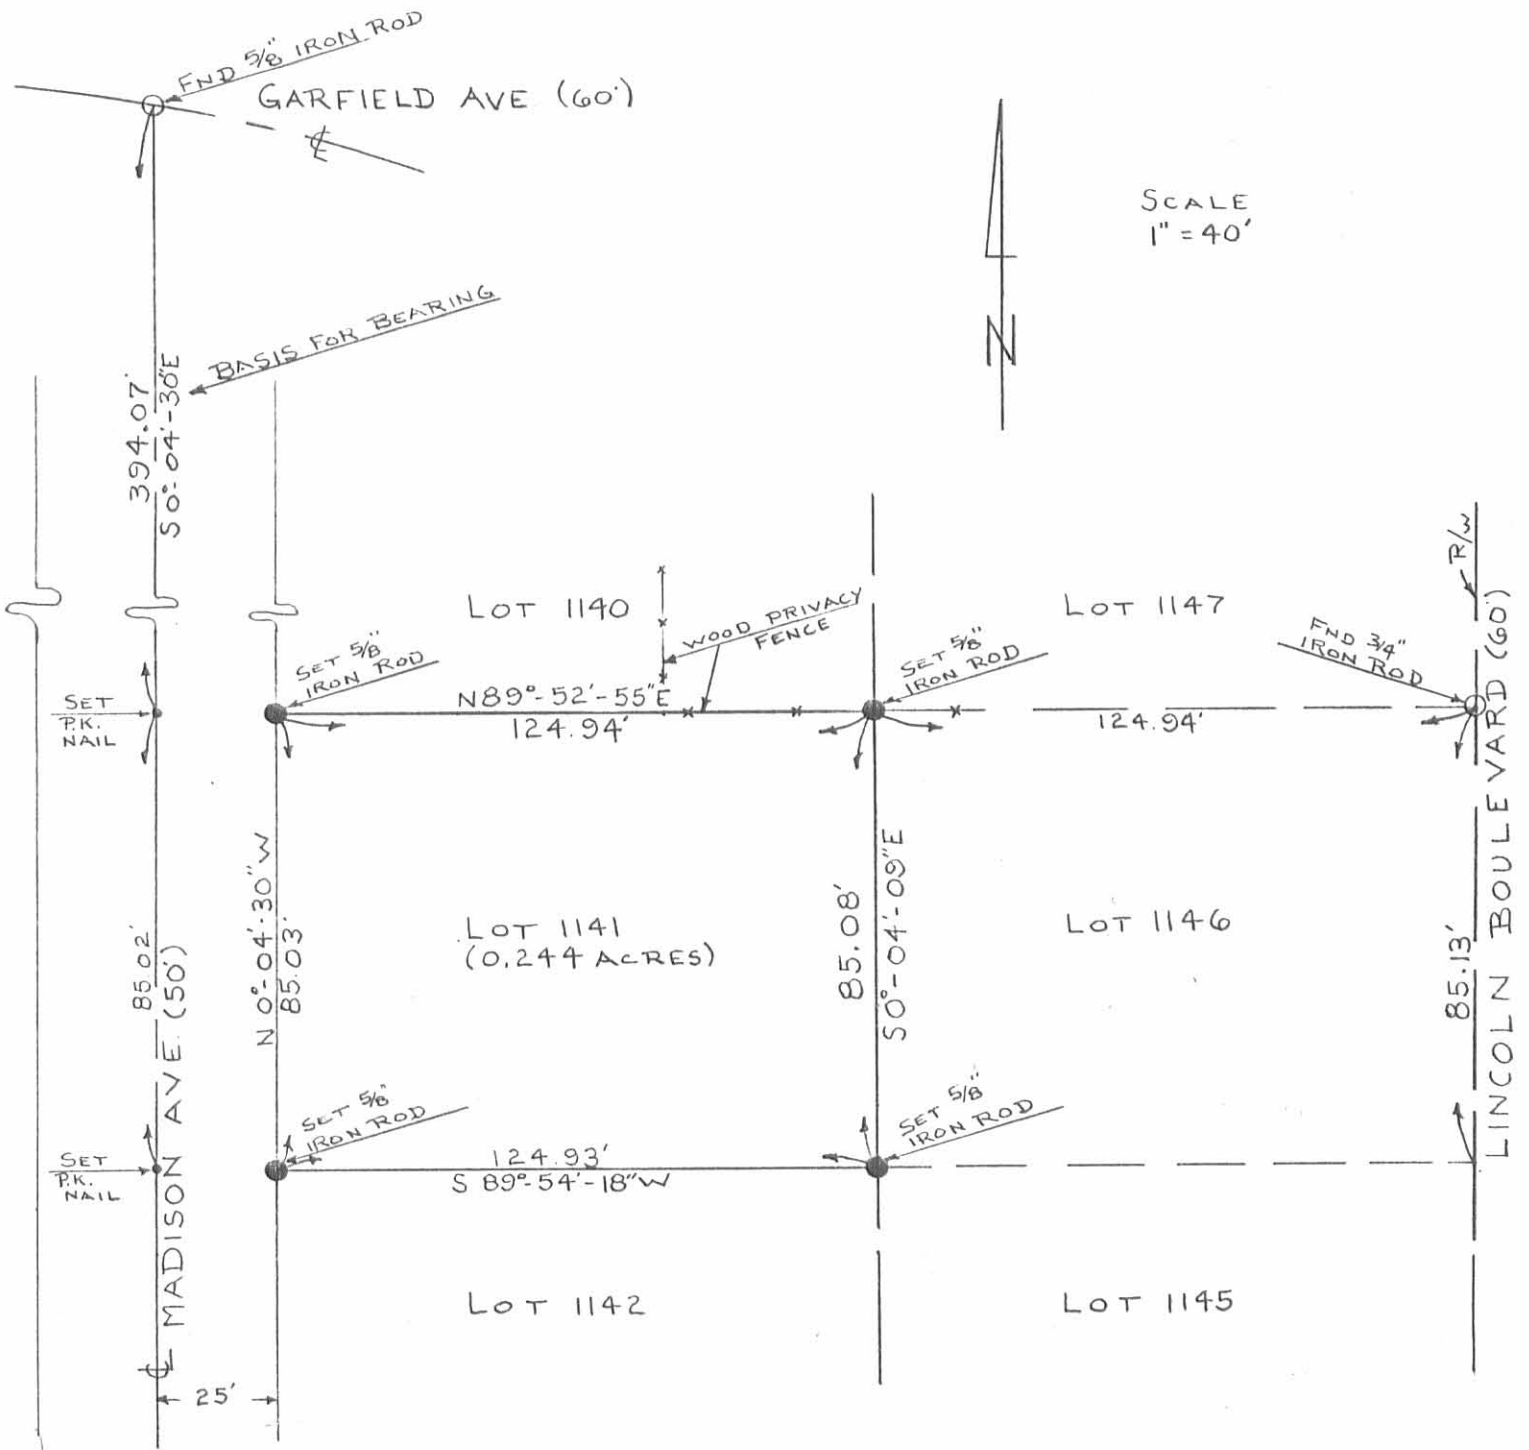

SURVEY OF LOT 1141
 OAK ACRES SUBDIVISION
 (ORIGINAL LOT NO. 1105)
 SEC. 1, TOWN 75, RANGE 8E
 WASHINGTON TWP.
 RUSSELLS POINT CORP.
 LOGAN COUNTY, OHIO

REFERENCES:
 LEE SURVEYING AND MAPPING CO.
 FILE 588-1A
 1160-2

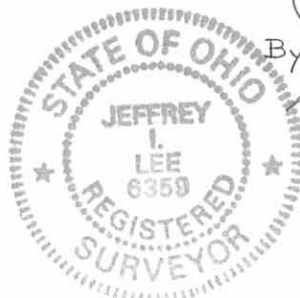

By *[Signature]*
 JEFFREY I. LEE
 PROF. SURVEYOR #6359
 August 2, 1991

ORIGINAL STAMP IN GREEN

INDEXED ON MAP
 8160 HP