

Lot 1134  
OAK ACRES

A = 1"  $\phi$  Bar Found

B = " " "

C = 5/8"  $\phi$  Set

D = 1"  $\phi$  Bar Found

E = " " "

F = " " "

G = 5/8"  $\phi$  Bar Set


H = " " "

INDEXED ON MAP  
9628

Dodson  
Artis

5/27/78

53

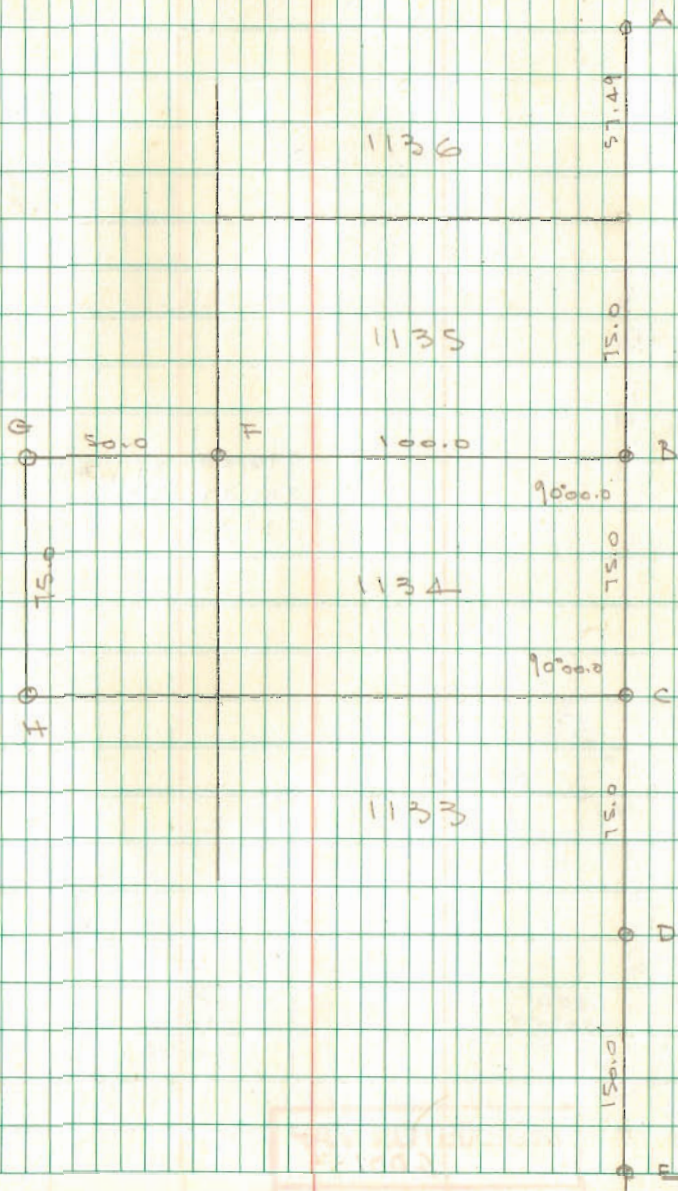

INDEXED ON MAP  
9628