


1-9-14

APPROVED

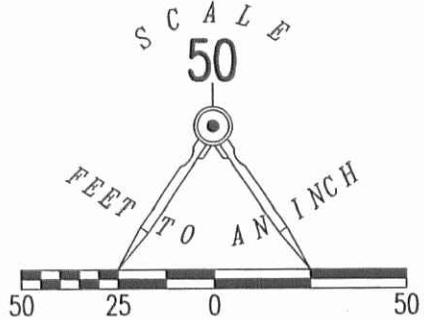

LEGEND:

- ⊗ RAILROAD SPIKE FOUND
- MAG NAIL SET
- 5/8 INCH IRON ROD FOUND
- 5/8 INCH IRON ROD SET WITH PLASTIC I.D. CAP STAMPED "LSM 7437"

ELLIOT ROAD

CHAMPAIGN NATIONAL BANK AND TRUST
 ONE ACRE
 O.R. 204, PG. 616
 TRACT I

RUSSELLS POINT CHURCH OF GOD, INC.
 ONE-THIRD ACRE
 O.R. 49, PG. 939

(0.305 ACRE) N 89°35'00" E
 (0.978 ACRE) 210.44'

1.283 ACRES

OF WHICH 0.214 ACRE IS WITHIN THE HIGHWAY RIGHT-OF-WAY

THE RUSSELLS POINT CHURCH OF GOD, INC.
 ONE ACRE
 VOL. 399, PG. 344

THE LOGAN COUNTY COMMISSIONERS
 13.92 ACRES
 VOL. 402, PG. 848
 THE FIRST THEREOF

RETRACEMENT SURVEY OF
 THE RUSSELLS POINT CHURCH OF GOD, INC.
 ONE ACRE TRACT
 VOLUME 399, PAGE 344
 AND ONE-THIRD ACRE TRACT
 OFFICIAL RECORD 49, PAGE 939
 SECTION 1, TOWN 7, RANGE 8
 VILLAGE OF RUSSELLS POINT
 WASHINGTON TOWNSHIP
 LOGAN COUNTY, OHIO

SURVEYED BY:

William K. Bruce

WILLIAM K. BRUCE
 PROFESSIONAL SURVEYOR 7437
 JANUARY 3, 2014



COPYRIGHT 2014 BY:
LEE SURVEYING & MAPPING CO., INC.
 117 North Madriver Street
 BELLEFONTAINE, OHIO 43311
 (937) 593-7335
 WWW.LSMINC.US
 surveys@lsminc.us

KSS D1113 56501113 L-5650-3

INDEXED ON MAP
 9670

2 WORKING DAYS
BEFORE YOU DIG
 CALL TOLL FREE 800-362-2764
 OHIO UTILITIES PROTECTION SERVICE