


## Auglaize Co

N 15° W

## Sec. 13 T6. R7.

- 167.36 Center Castle of Huber pike see line east  
 176.14 point, (Tuesday March 17-1885)  
 197.18 Center 5 points pike  
 198.57 " of ditch runs eastward  
 200.46 point in west fence side road  
 228.64 Center of Ditch runs eastward  
 240.03 Point near see corner

## Sec. 13 T6. R7.

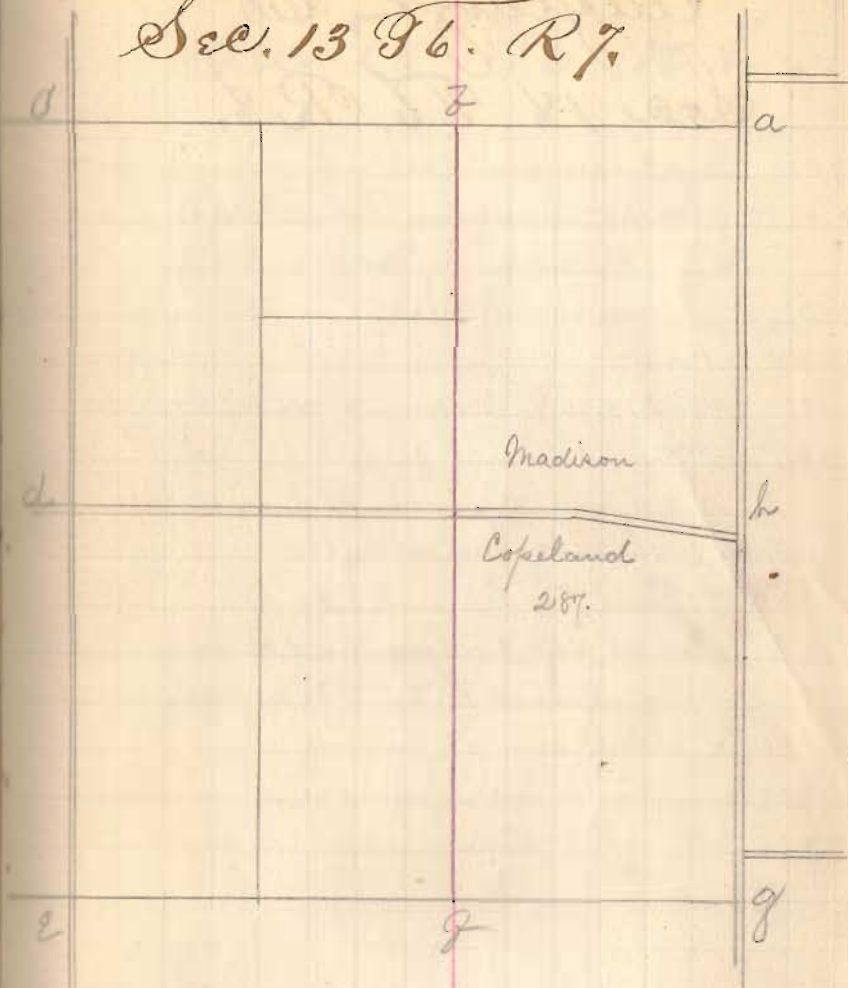

Traverse line N 15° W 9.60'

535

INDEXED ON MAP