


Lot. 19 chippewa Park No. 1  
 Stokes Twp.  
 V.M.S. 12276

April - 8 - 1934  
 Cool - Grand Prairie  
 F. Wright  
 E. Cole

30

- ⊙ Hubs Found
- ⊙ Irons Found
- 2x2 Hubs Placed

Lots 35x75

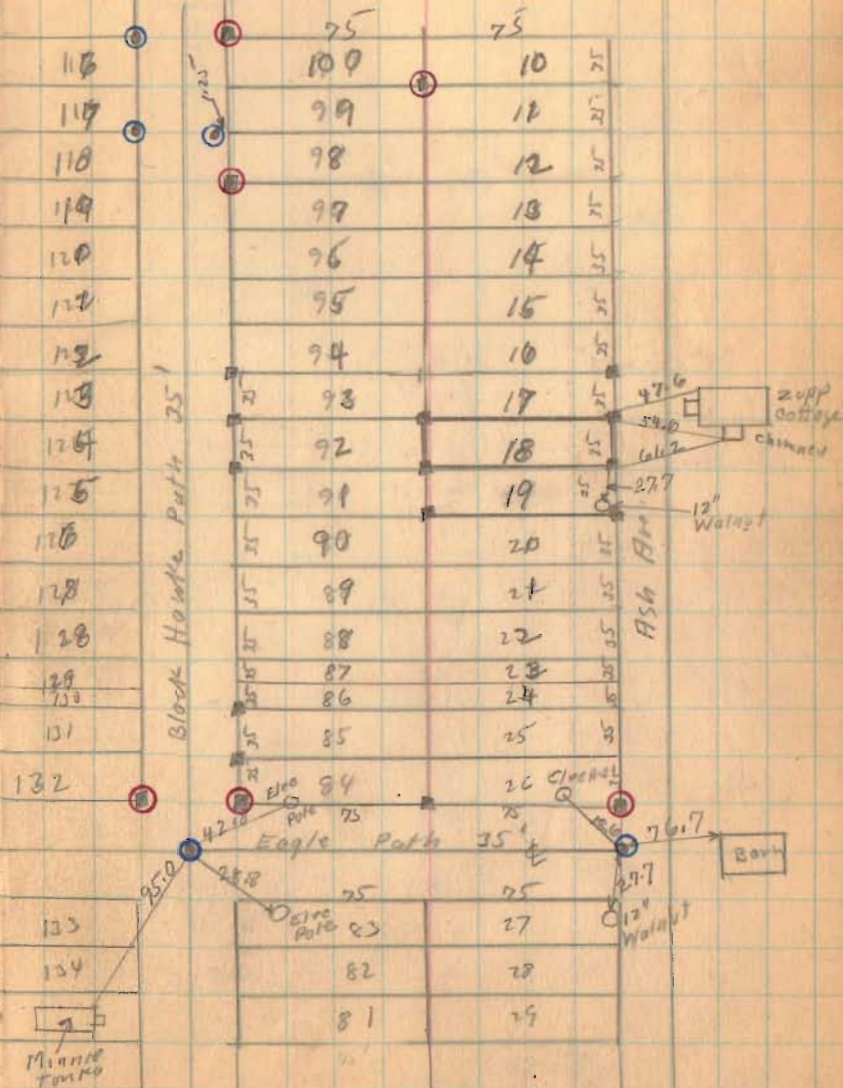


1909  
 INDEXED ON MAP

(over)

Lot. 19 chippewa No. 1

4-8-36

31

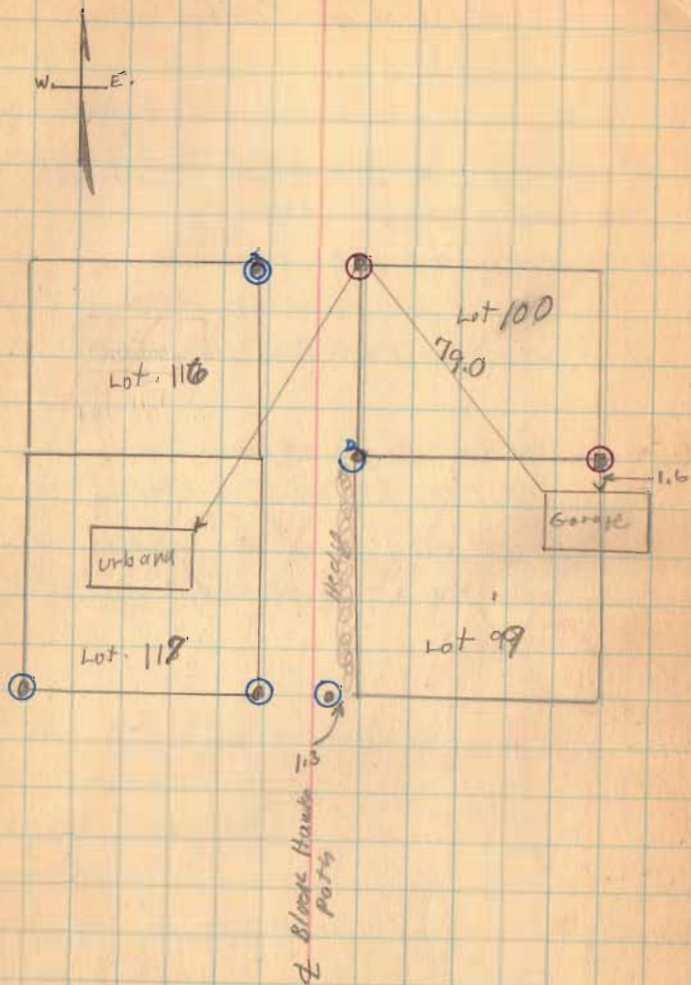

1709

INDEXED ON MAP