


# Survey of Rosewood Avenue

Wises + Nicholson's Island View,  
Stokes Twp.

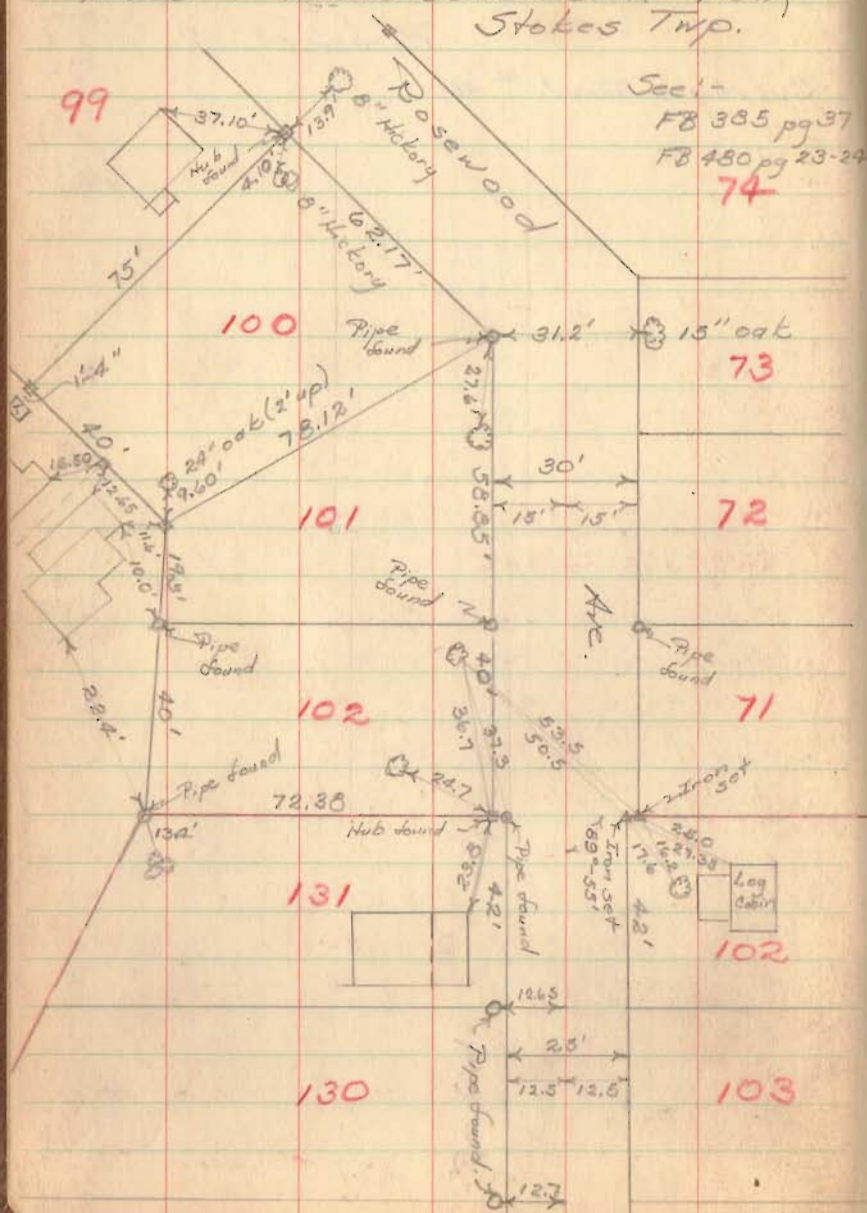

Party:-  
C. Keyser  
D. Dodson  
D. Mitchell  
N. Keyser

June 4 1949  
Fair Hot 80° 5

2000 Indexed on map

See detail  
←

