





FB 699

C. H. No. 86
Stakes Twp.

No Stakes Set

J. Jackson
T. Richardson
E. Webster
D. Craig

Aug 19, 1955
90° 85

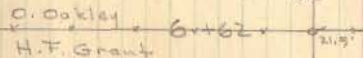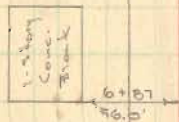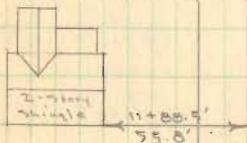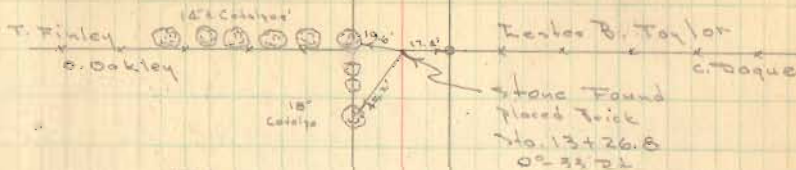

2452

C. H. # 87




FB 699

C. H. No. 86

Aug 19, 1955

90°



56

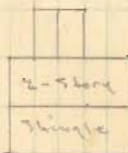

58.9°
59+89.6

Tessie H.

Taylor

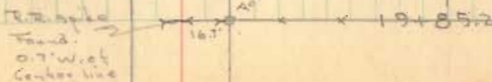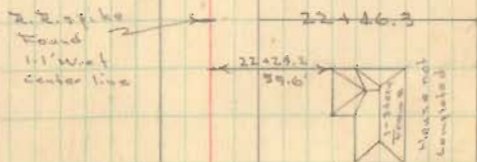

Tessie H.

Taylor

FB 699


C. H. 10 86

Aug 19, 1955

67




R-7

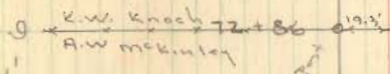

T-6

Sec. 18

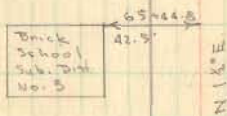

Sec. 18

Harvey V. Whitaker

R-6

T-6

17

Sec. 18



T. I. Finley

H. V. Whitaker


Sec. 19-6-7

Sec. 20-6-7

C.H. No. 86

FB 699

68

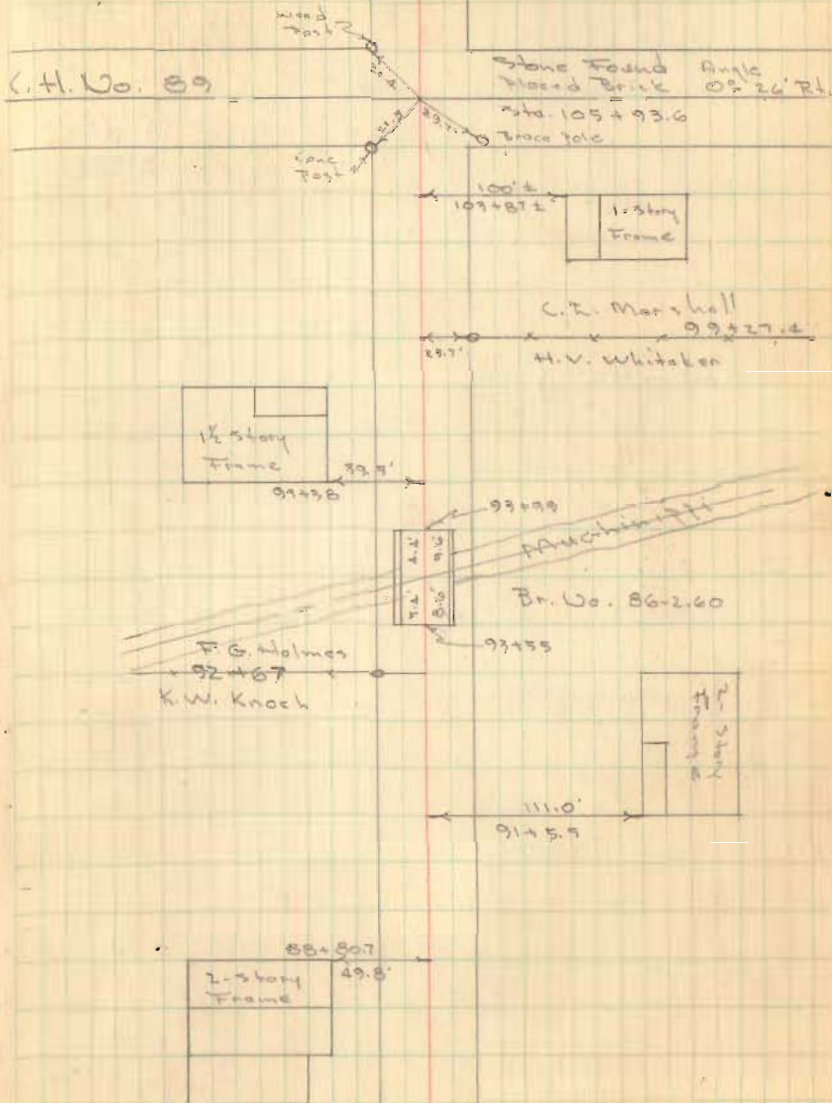

FB 699

C. H. Co. 86

Aug 29, 1955
cloudy

69

AUGLAIZE

Co. line
Stone

Stone Found

Flaced Brick

132 + 43.1

Coupling line

Sec. line

LOGAN

125 + 79.7

189.7

700.0

179.7
700.0

122 + 44.4

100.0

200.0

122 + 44.4

