

Hull - Marty Survey " Turkeyfoot " Stokes Township April 1962 0.03 Acre

The following described land in Stokes Township, Logan County, Ohio and being in V.M.S. 12276

Beginning at an iron known as State Monument Number 5 as shown on Logan County Engineer's map J - 4 - A. Thence with the State Line so called from Monument Number 5 to Monument Number 4 N. 7 - 00 E. 14.70 feet to an iron in the south side of E.L.Drew's 0.15 acre tract.

Thence with the south side of said Drew's 0.15 acre tract S. 58 - 30 E. 34.40 feet to an iron in the west side of State Route Number 702. (State Route Number 702 being 50.00 feet wide)

Thence with the west side of Said State Route Number 702 S. 31 - 35 W. 50.00 feet to an iron.

Thence N. 66 - 31 W. 12.50 feet to an iron, in the State line so called.

Thence with the State Line so called (being the line from Monument Number 6 to Monument Number 5) N. 12 - 00 E. 41.70 feet to the place of beginning.

The above described contains 0.03 of one acre.


cc
Logan County Engineer.
Mr. A. Roy Marty



(2748) -1D

INDEXED ON MAR

HULL-MARTY SURVEY "TURKEYFOOT"
 V.M.S. 12276 - STOKES TOWNSHIP
 LOGAN COUNTY, OHIO
 SCALE: 1"=20'
 SURVEYED BY F. F. WRIGHT #1673 - APRIL 1962

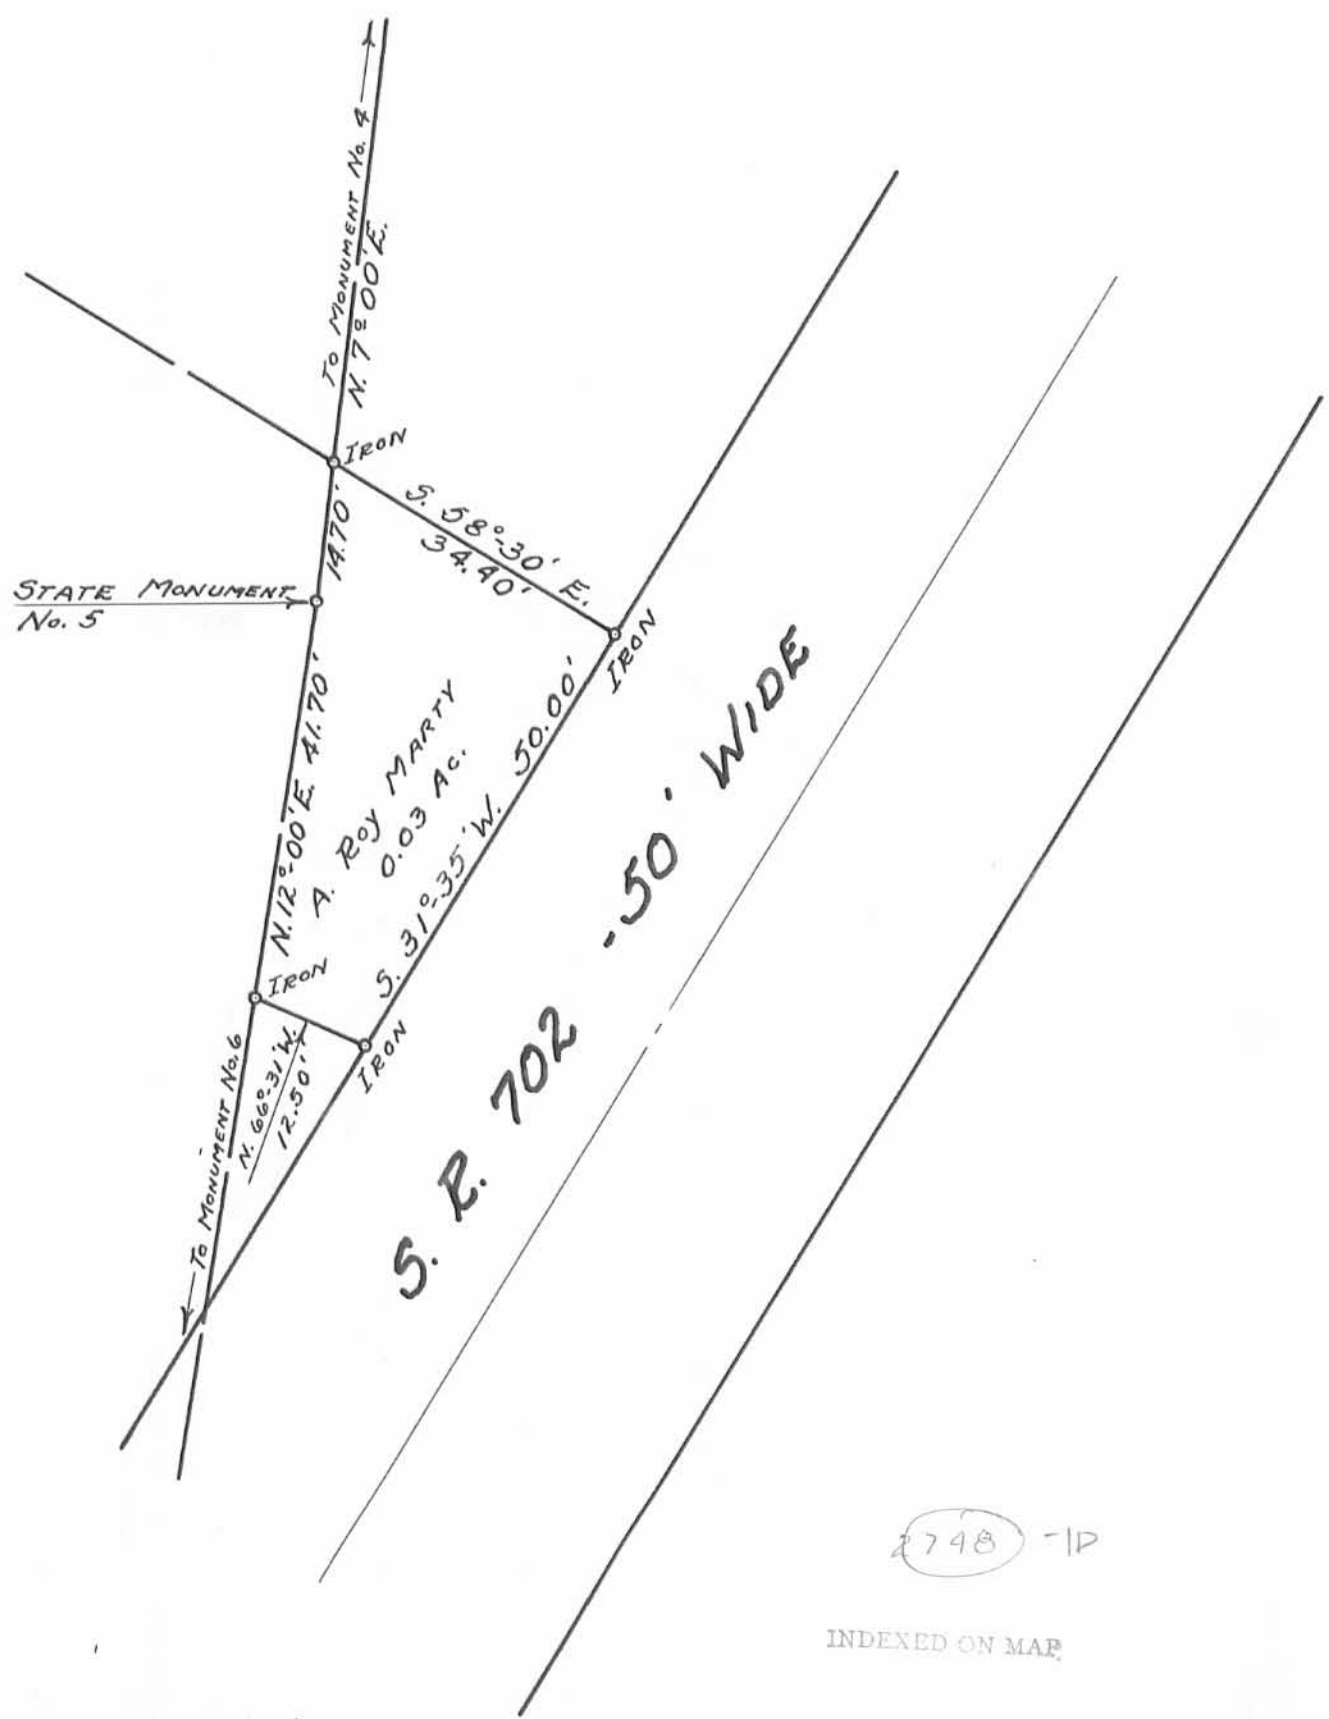

2748 - 1D

INDEXED ON MAP

DRAWN BY D.E.G. 5/4/62