


# NICHELSON'S ISLAND VIEW ALLOTMENT

Note:  
A PART OF COTTONWOOD  
AVE. VACATED, JULY 27, 1964.  
COMMISSIONERS JOURNAL 1-Z  
D.E.G.

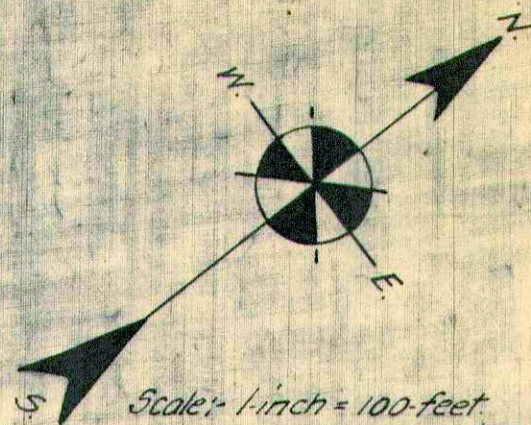

**AUDITORS OFFICE:-**

Transferred this 16 day of Aug 1917

*C. W. Laffer*  
Auditor of Logan Co., O.

**RECORDERS OFFICE:-**

Received for record this 16 day of Aug 1917.

Recorded this 19 day of Sept. 1917.

*R. M. Painter*  
Recorder of Logan Co., O.

**ACKNOWLEDGEMENT:-**

State of Ohio, Logan County, S.S.

Before me a notary public in and for said County and State, personally came Charles Nicholson the grantor in the foregoing instrument and acknowledged the same to be his free and voluntary act for the uses and purposes therein mentioned.


In testimony whereof I have here unto set my hand and affixed my official seal this 31 day of July 1917.

*J. J. [Signature]*  
Notary Public.

**SURVEYORS CERTIFICATE:-**

I, the undersigned Surveyor, do hereby certify, that the annexed plat is a correct representation of "Nichelson's Islandview Allotment", as surveyed and laid out by me, July 11<sup>th</sup> & 12<sup>th</sup> 1917, at the instances of the proprietor.

*Fred W. McManis*  
Dep. Surveyor  
Logan Co., O.

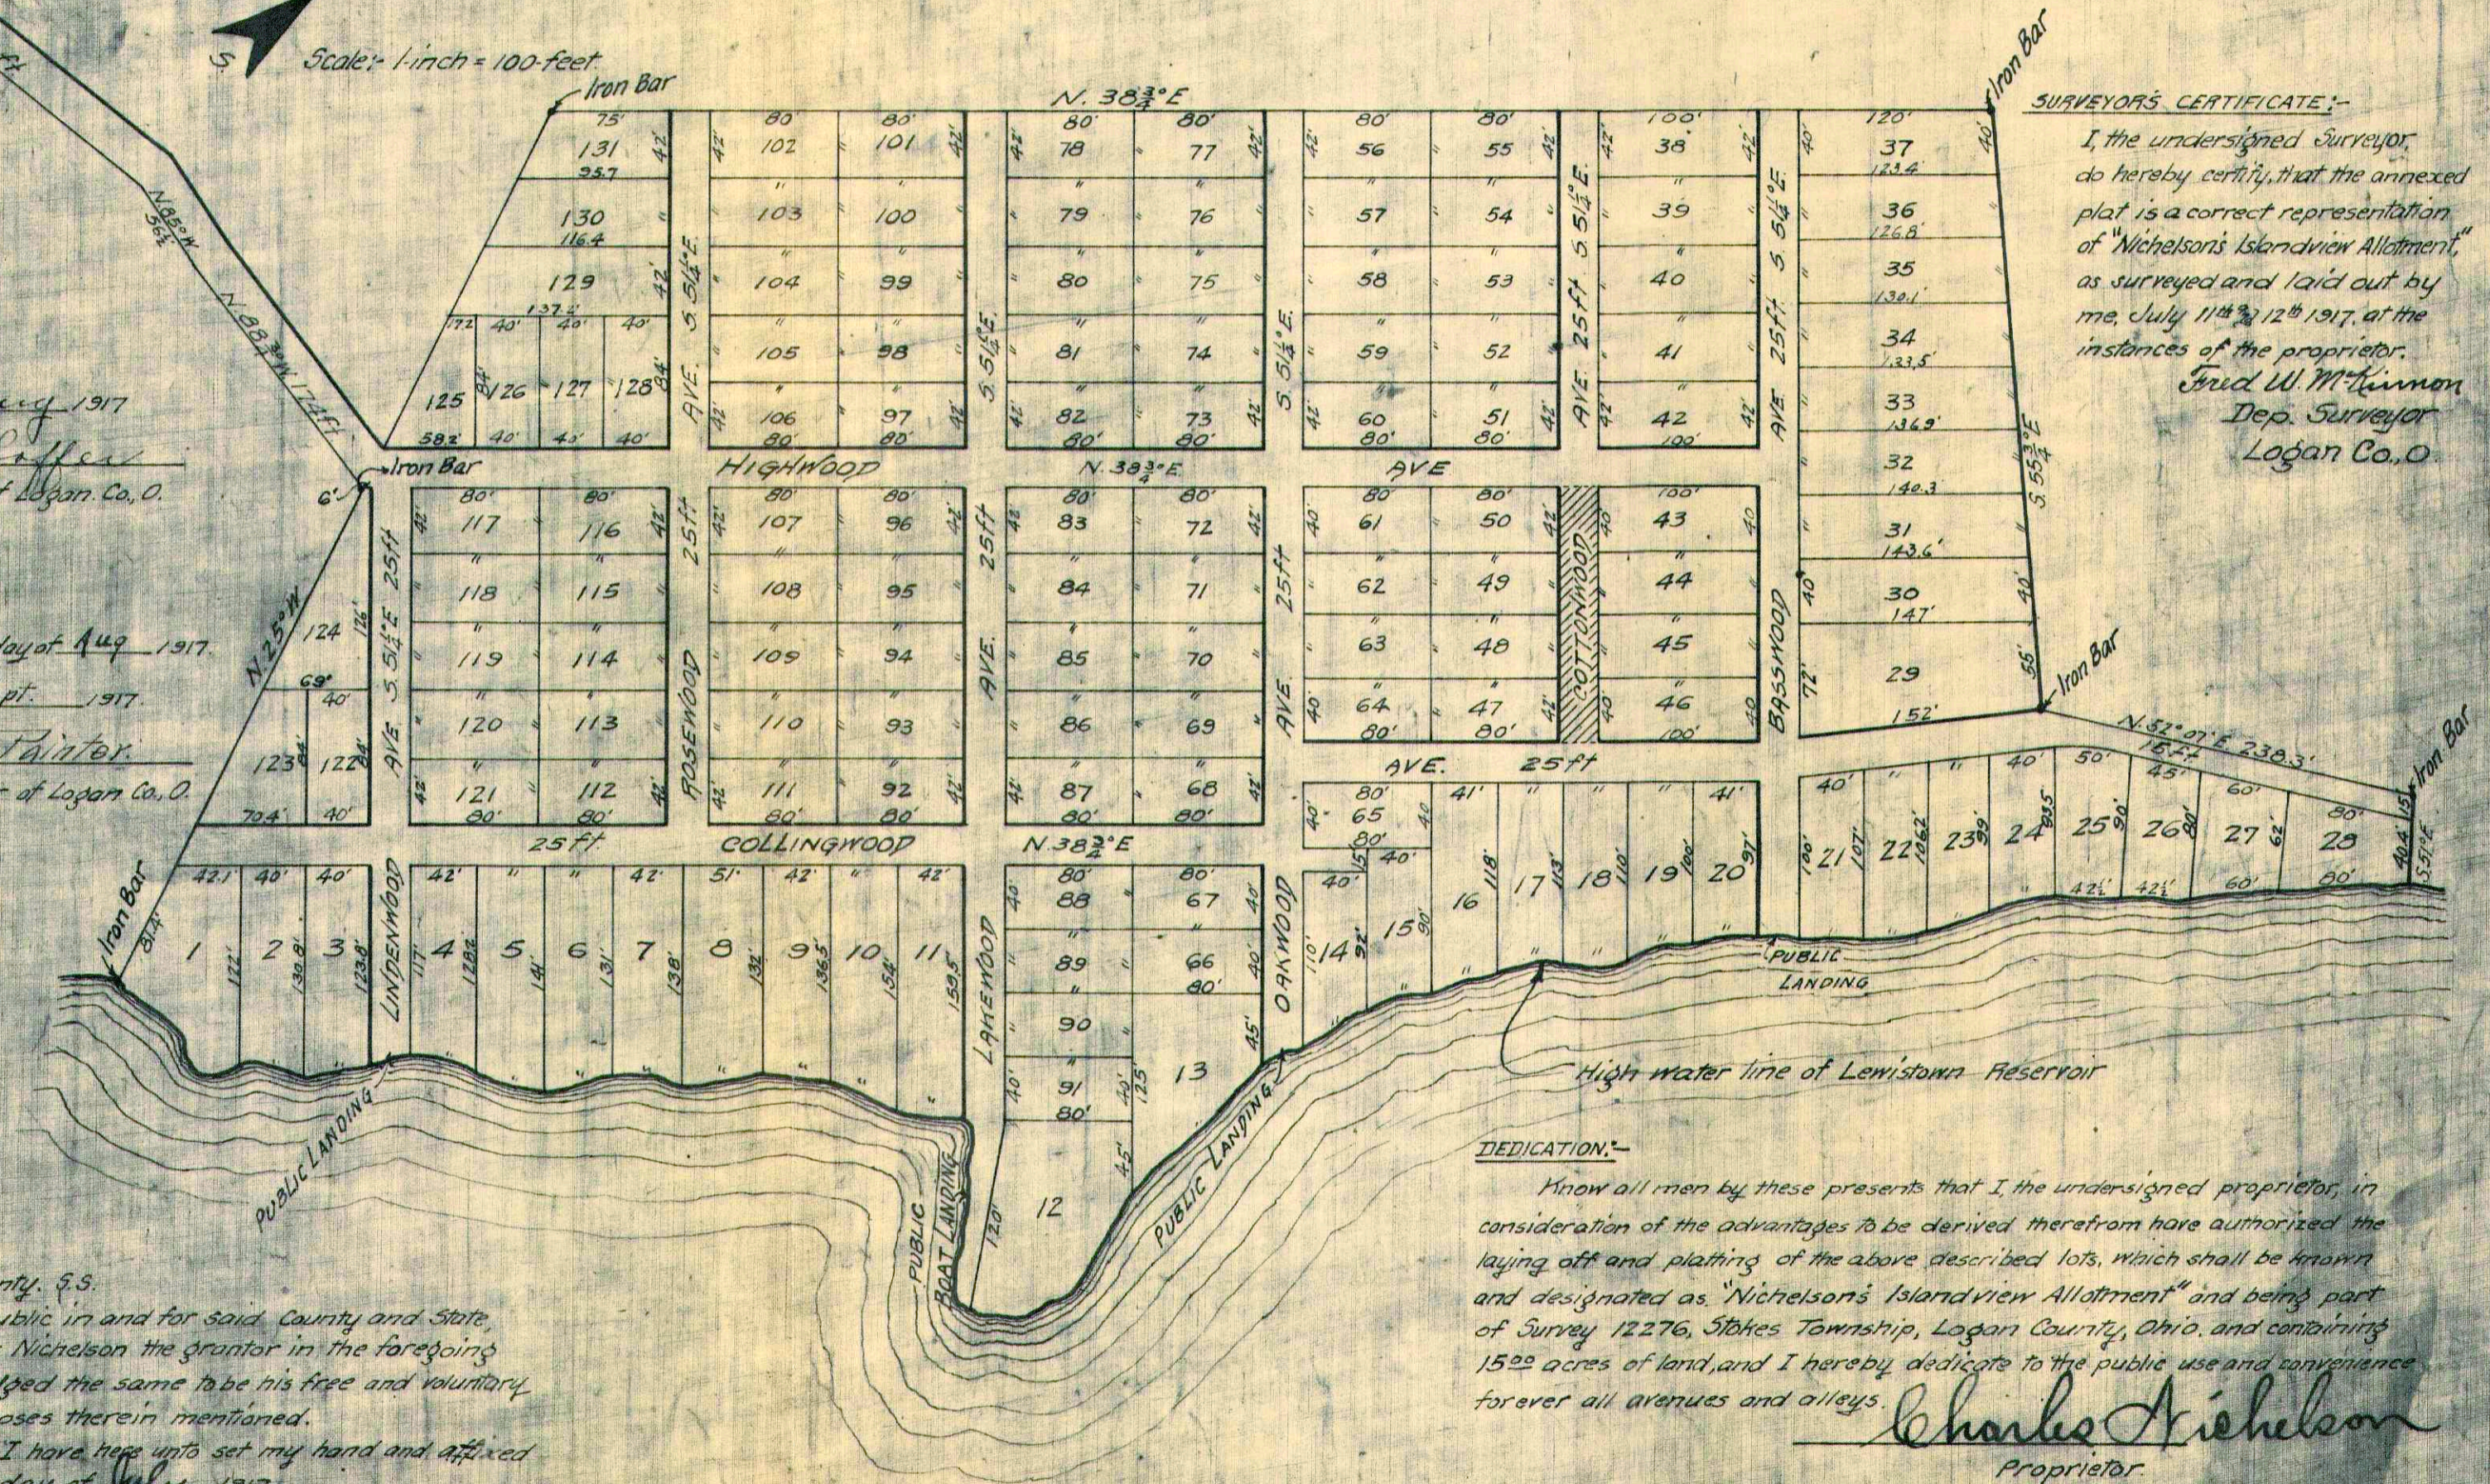

**DEDICATION:-**

Know all men by these presents that I, the undersigned proprietor, in consideration of the advantages to be derived therefrom have authorized the laying off and plating of the above described lots, which shall be known and designated as "Nichelson's Islandview Allotment" and being part of Survey 12276, Stokes Township, Logan County, Ohio, and containing 1500 acres of land, and I hereby dedicate to the public use and convenience forever all avenues and alleys.

*Charles Nicholson*  
Proprietor.



The Board of Commissioners of Logan County, Ohio met regular session on this date of July 27, 1964 at the Commissioners office, Bellefontaine, Ohio with the following members of the Board responding to roll call.

Mr. William A Fox, Pres. Present  
Mr. G. Evertt Knowlton, V. Pres. Present  
Mr. Foster A Cole, third member Absent

Mr. G. Evertt Knowlton moved to adopt the following Resolution:

RE: STREET VACATION  
COTTONWOOD AVE.  
NICHELSON'S ISLAND VIEW  
ORC 5553.04

Whereas, time having arrived for the hearing on the vacation of a portion of the above named street, as petitioned for by John W. Lawrence and twelve other freeholders, more fully described as follows: Situated in Nicholson's Island View Allotment, Virginia Military Survey No 12276 Stokes Township, Logan County, Ohio.

Commencing at a point in the North Line of Collingwood Ave. in the center of Cottonwood Ave: Said point being midway between the Southwest Corner of Lot No 46 and the Southeast corner of Lot No. 47 of said Nicholson's IslandView Allotment; thence with the center of Cottonwood Ave., Northwesterly between Lots No. 43, 44, 45, 46, 47, 48, 49, and 50 to the south line of Highwood Ave. and there terminate.

Whereas, no one was present at the hearing to voice against the vacation.

Therefore, the Board of Commissioners of Logan County, voted to vacate the above named portion of Cottonwood Ave.

Mr. William A. Fox seconded this motion and roll call resulted as follows:

Mr. William A. Fox yes  
William A Fox, Pres.

Mr. G. Evertt Knowlton yes.  
G. Evertt Knowlton, V. Pres.

Mr. Foster A Cole absent  
Foster A Cole, third member

Adopted July 27, 1964

Attest Geo. W. Ansley  
Geo. W. Ansley, Clerk

State of Ohio, Logan County, S. S.

Received April 7 1966

at 1:06 O'clock P. M.

Recorded April 8 1966

Vol. No. 307 Page 39

Ruth Royer  
RECORDER, LOGAN COUNTY, OHIO

July 27, 1964

181926