

SURVEY OF LOT 377
 AVONDALE No.5
 STOKES TOWNSHIP-LOGAN COUNTY, OHIO
 JUNE 15, 1963
 SCALE 1"=20'

REFERENCE:
 AVONDALE No.5
 PLAT BK.C
 VOL. 3
 PAGE 31

Dan L. Dodson

Dan L. Dodson
 Reg. Surveyor 4270
 Bellefontaine, Ohio




□ = 1/2" Iron Bar Set.


ON PLAT BOOK
 3-31-64
 D.E.G.

IP
 3649
 INDEXED ON MAP R

INDIAN LAKE

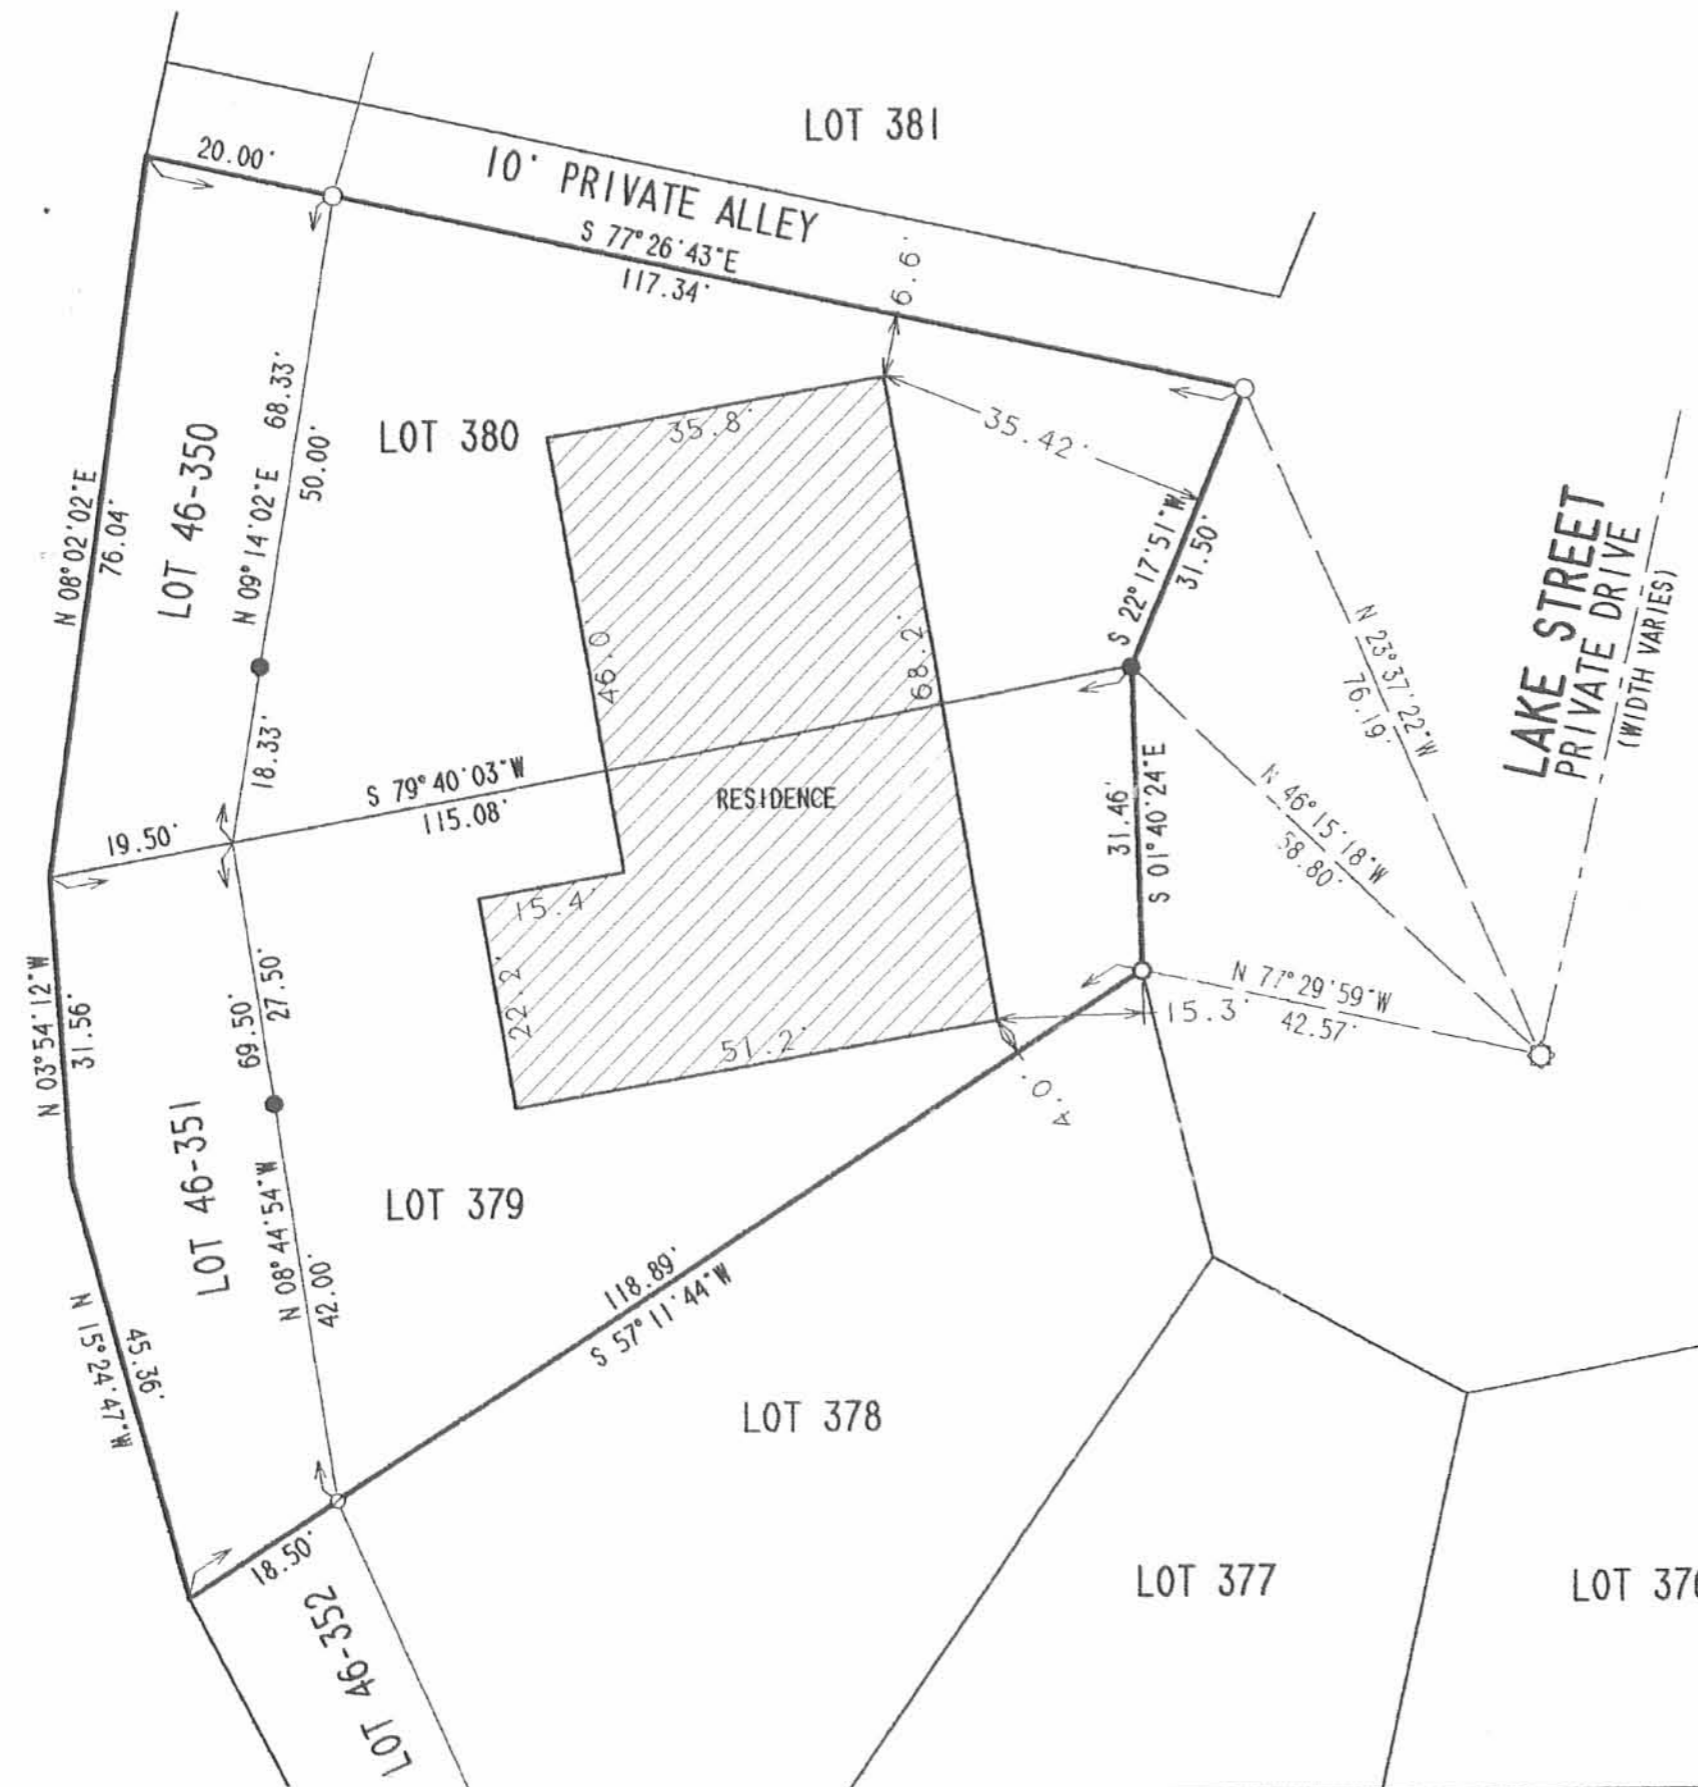

- LEGEND**
- 5/8 INCH IRON ROD SET
 - 5/8 INCH IRON ROD FOUND
 - ⊗ 1/2 INCH IRON ROD FOUND
 - ⊙ 2 INCH IRON PIPE FOUND
 - ⊛ 1 INCH IRON PIPE FOUND

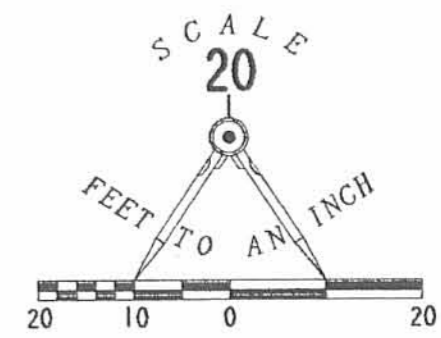

**RETRACEMENT SURVEY OF
 LOT 379 AND LOT 380 OF
 AVONDALE ALLOTMENT NO. 5
 PLAT CABINET A. SLIDE 249
 AND INDIAN LAKE RESERVOIR LANDS
 LOT 46-350 AND LOT 46-350
 PLAT CABINET A. SLIDE 471
 VIRGINIA MILITARY SURVEY 12276
 STOKES TOWNSHIP
 LOGAN COUNTY, OHIO**



SURVEYED BY:
(Signature)
 JEFFREY I. LEE
 PROFESSIONAL SURVEYOR 6359
 MAY 15, 2003

COPYRIGHT 2003 BY:
 LEE SURVEYING & MAPPING CO., INC.
 117 North Madriver Street
 BELLEFONTAINE, OHIO 43311
 (937) 593-7335

D 407 TWALLACE L-3587-3

INDEXED ON MAP
 3649 -2P