


INDIAN LAKE

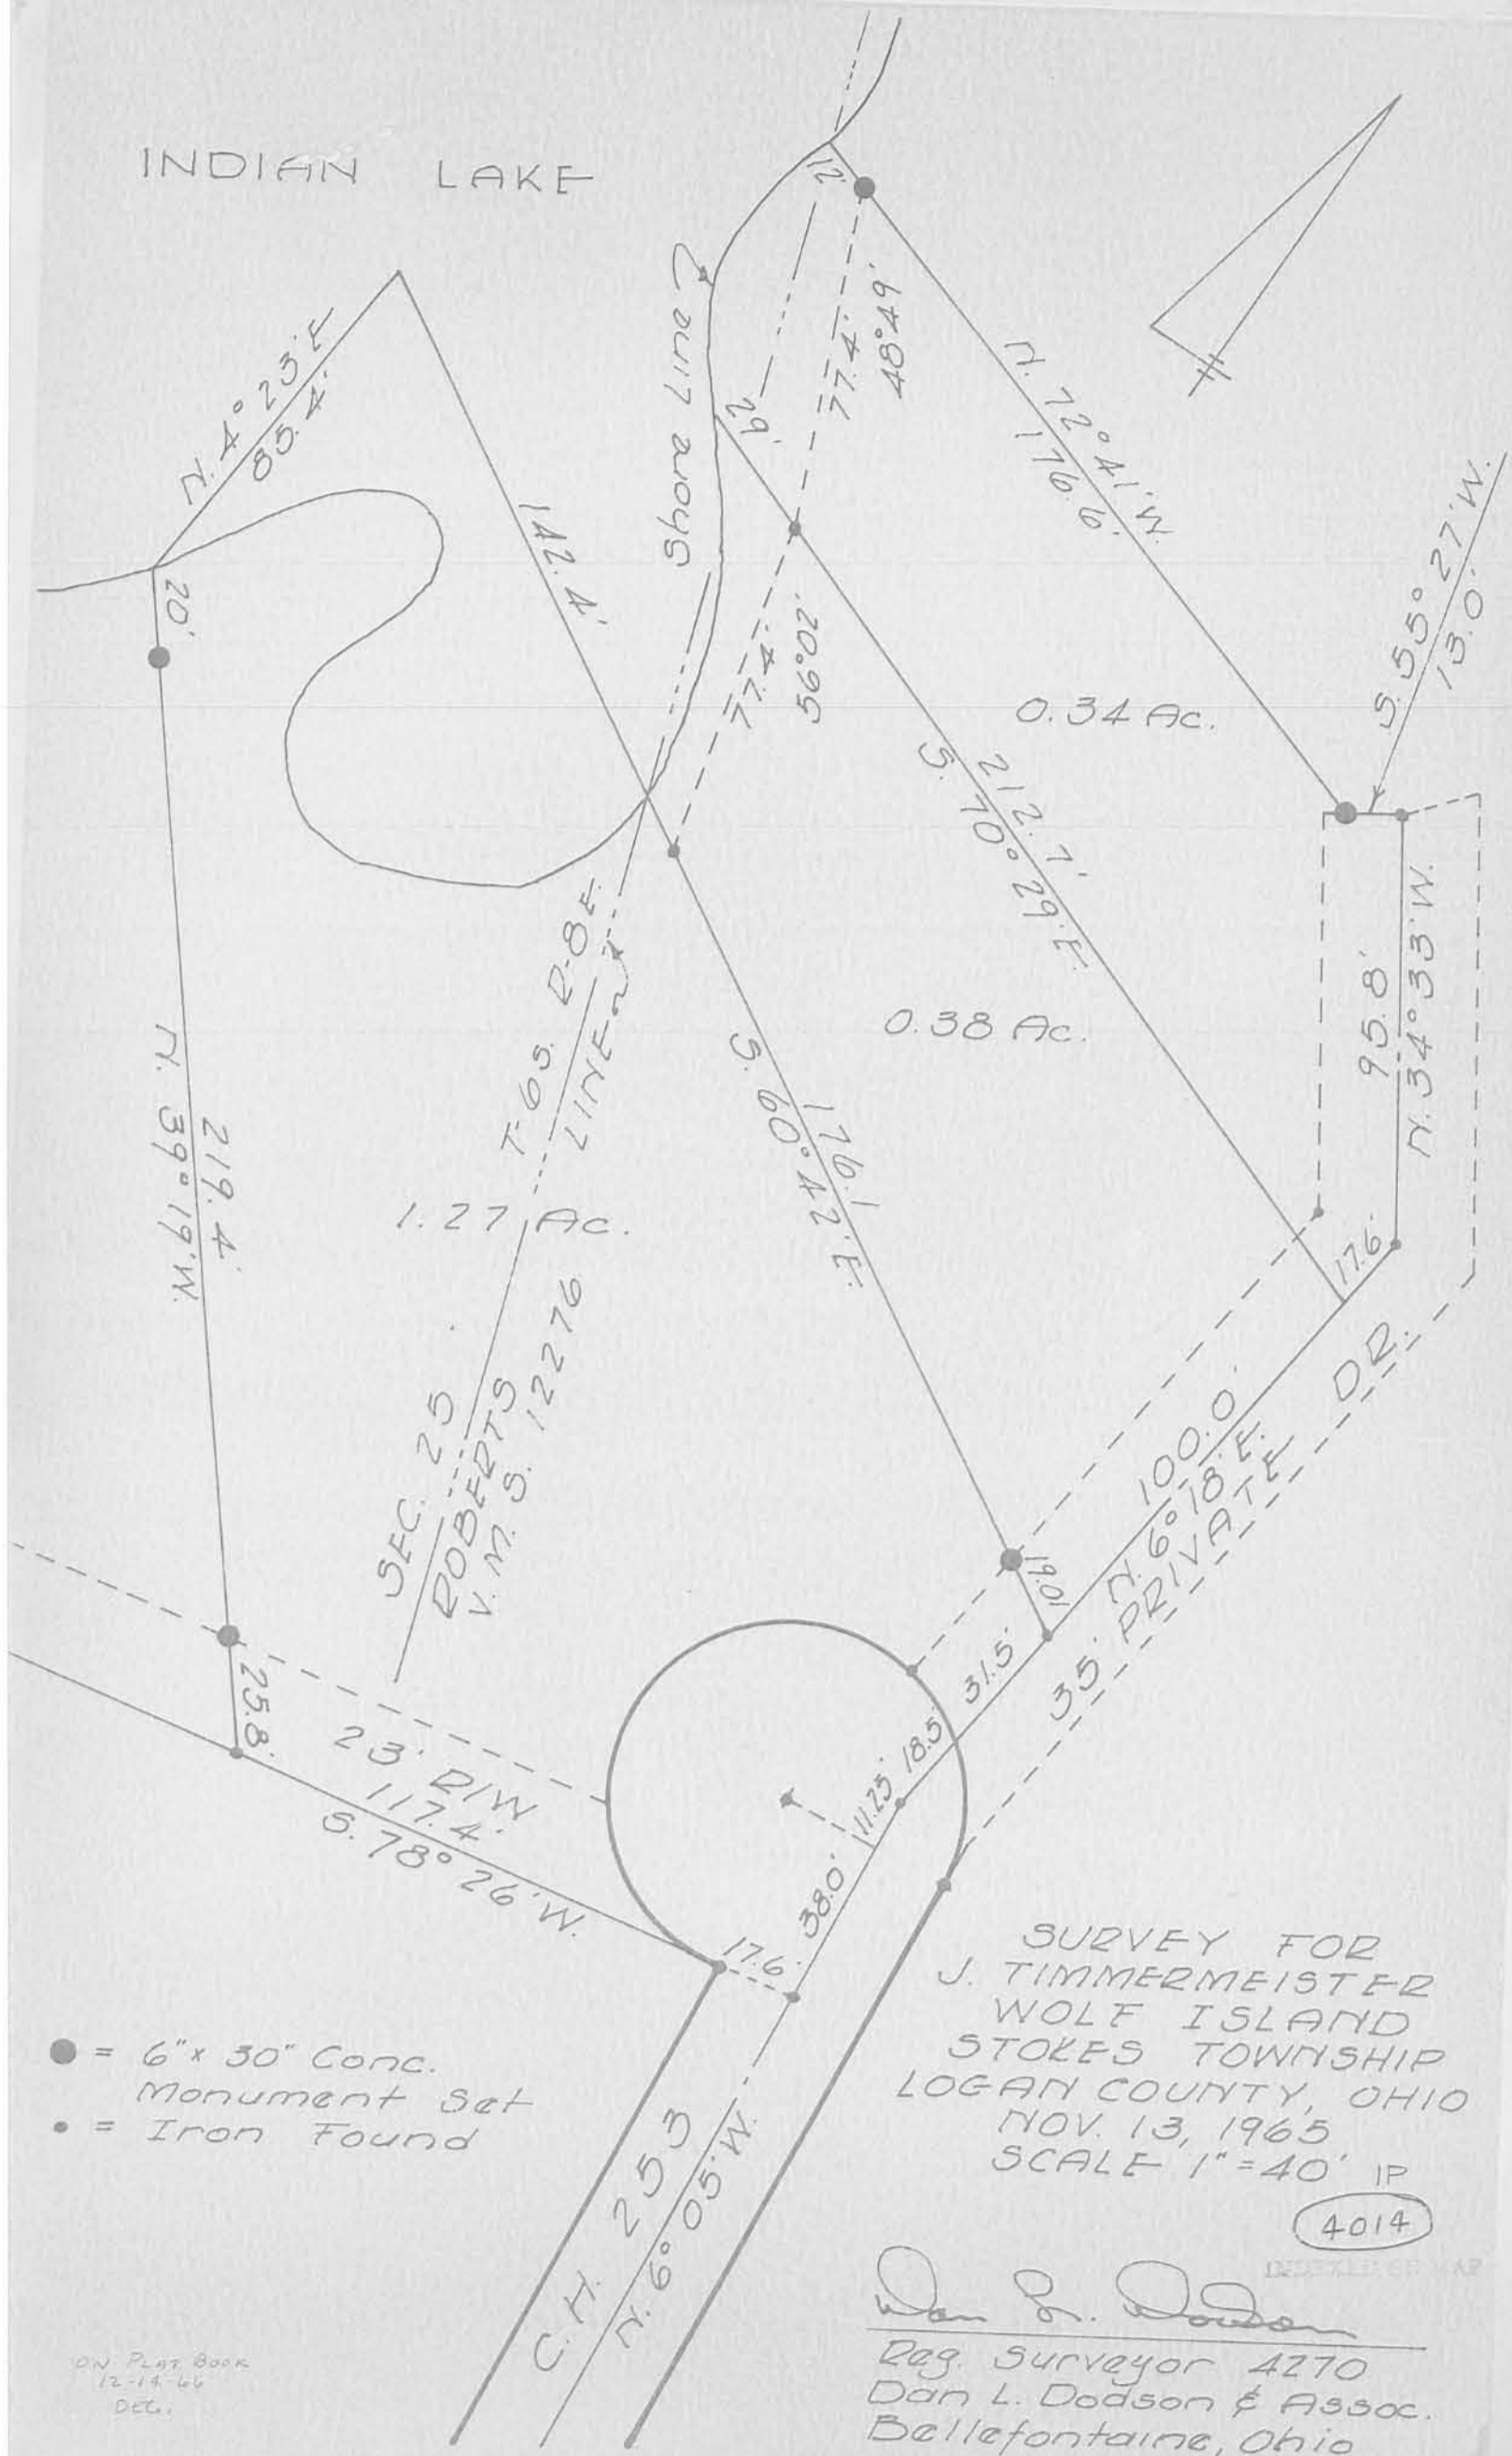

- = 6" x 30" Conc. Monument Set
- = Iron Found


SURVEY FOR
 J. TIMMERMEISTER
 WOLF ISLAND
 STOKES TOWNSHIP
 LOGAN COUNTY, OHIO
 NOV. 13, 1965
 SCALE 1" = 40' IP

4014

Dan L. Dodson
 Reg. Surveyor 4270
 Dan L. Dodson & Assoc.
 Bellefontaine, Ohio

SURVEY FOR
 J. TIMMERMEISTER
 WOLF ISLAND
 STOKES TOWNSHIP
 LOGAN COUNTY, OHIO
 NOV., 1967
 SCALE 1" = 40'

- = 6" x 30" Concrete Monument Set
- = Iron Found

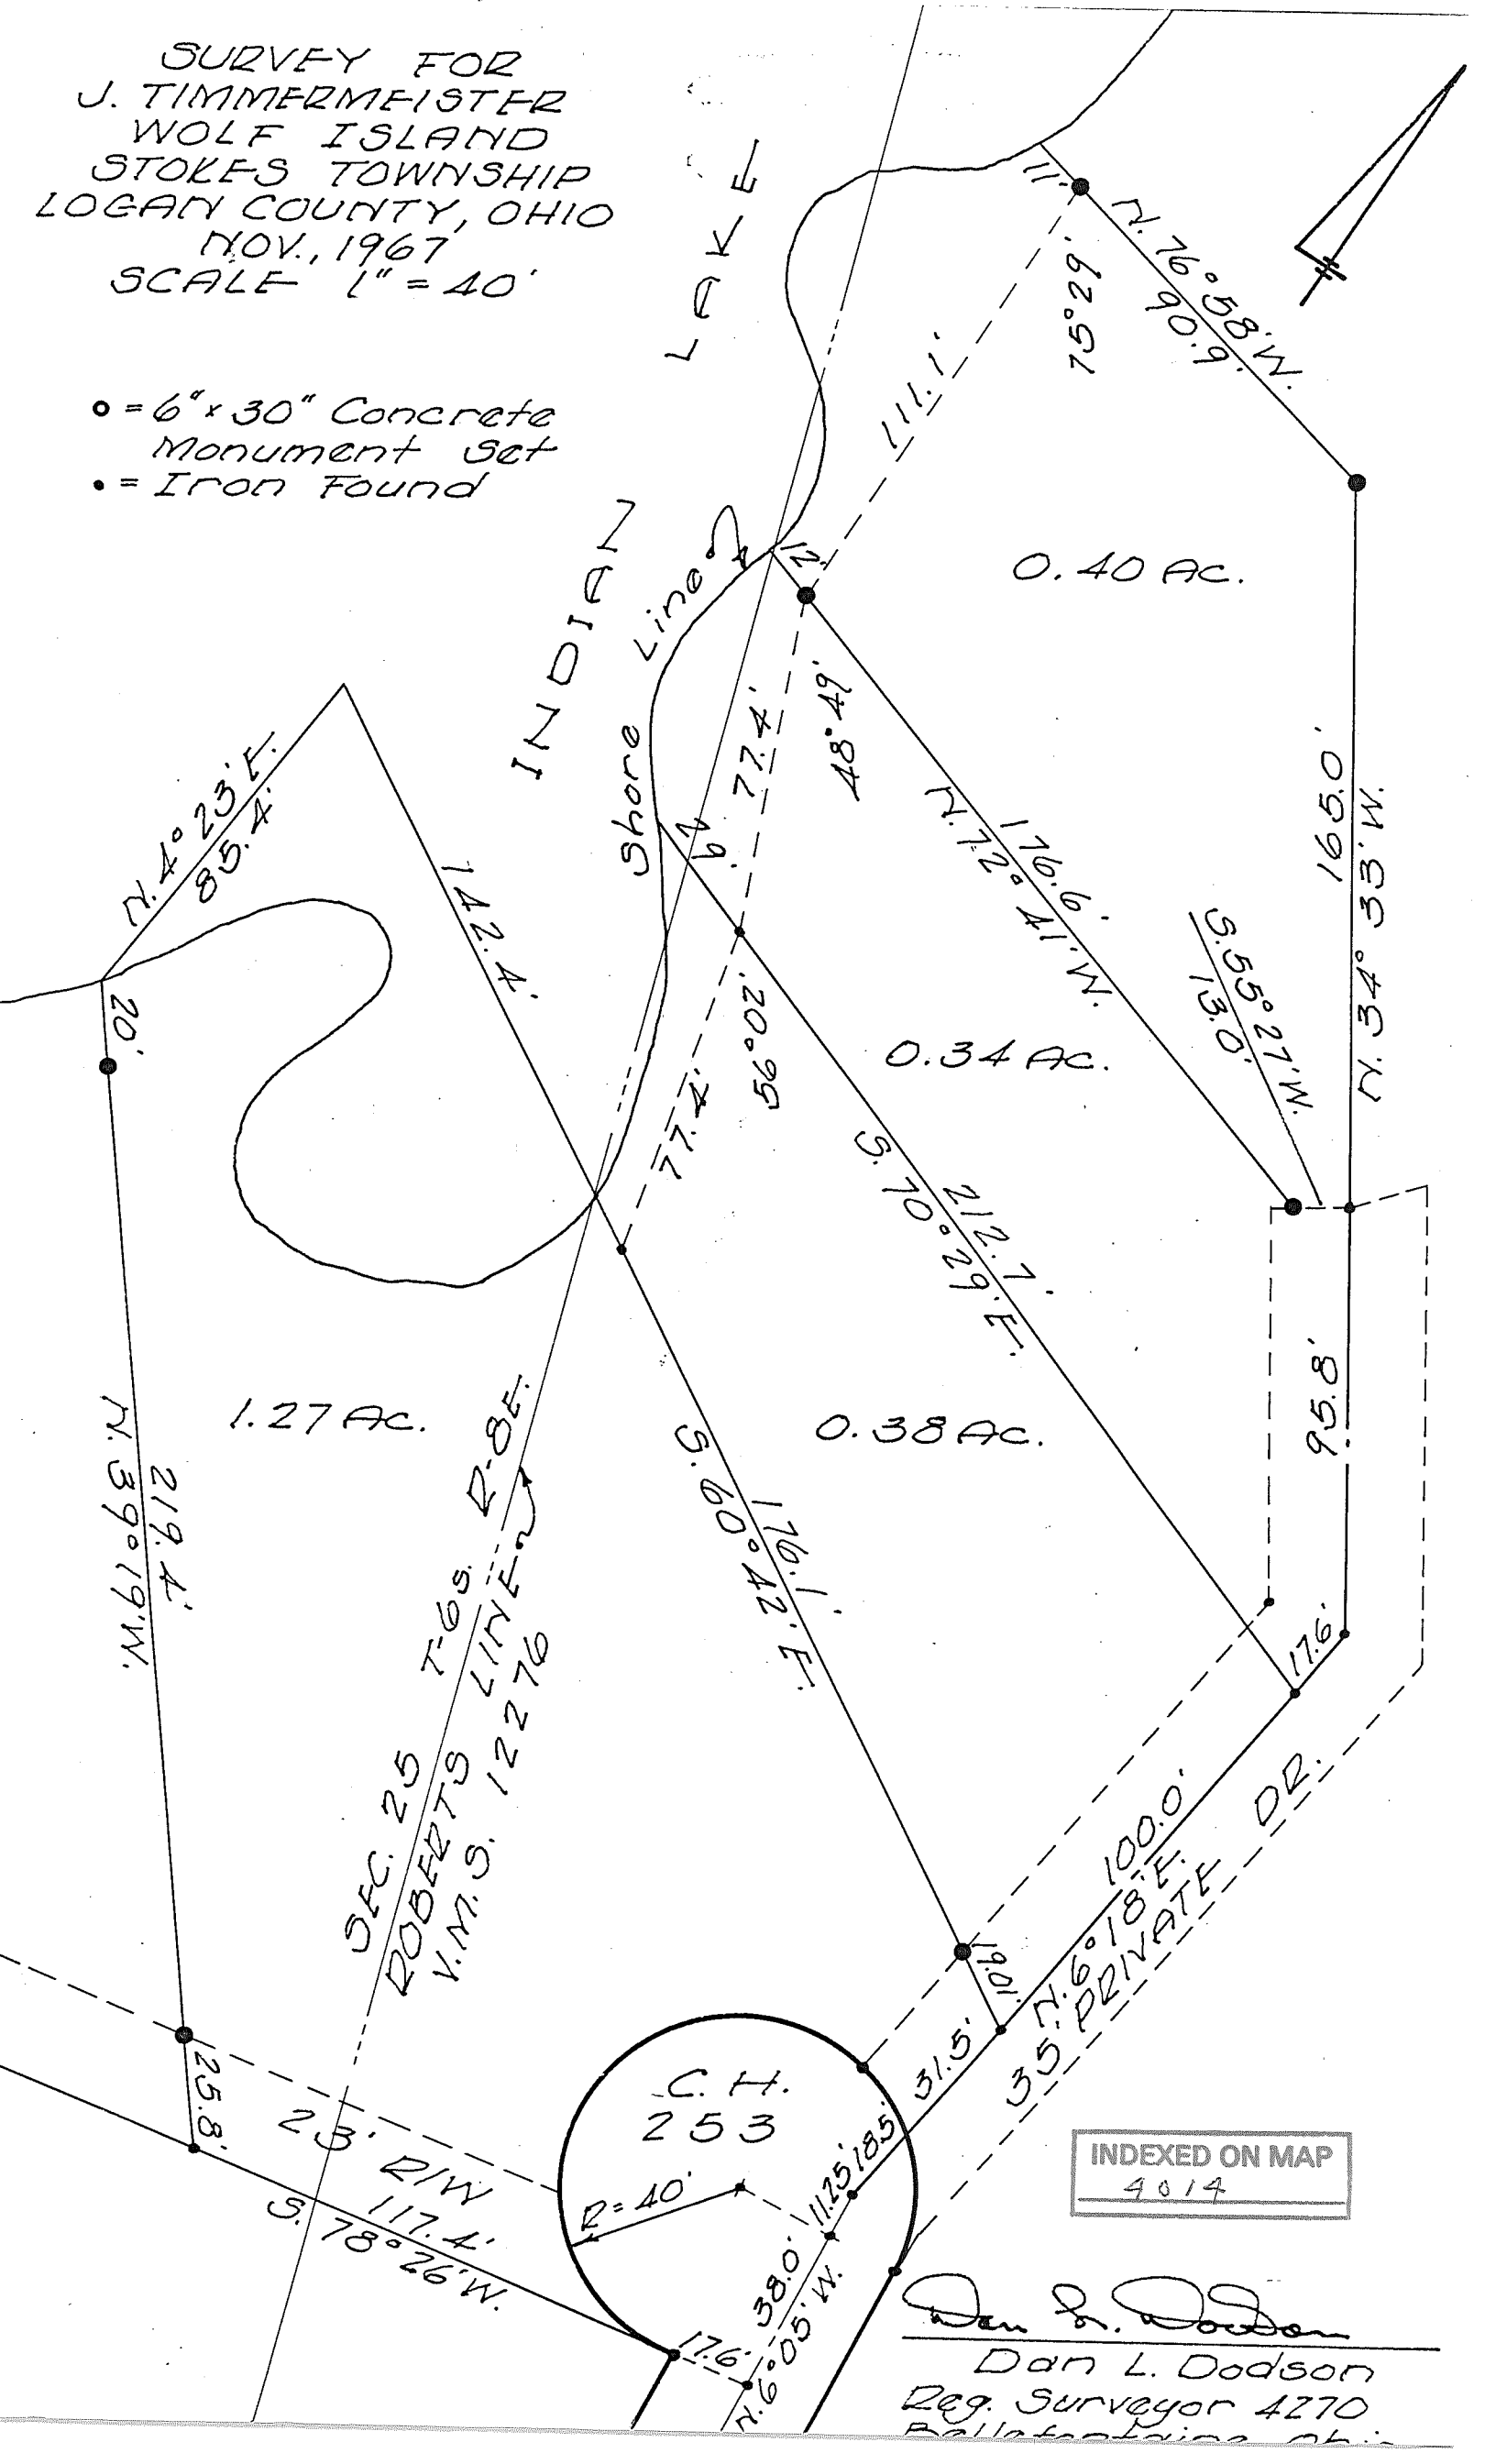

INDEXED ON MAP
 4014

Dan L. Dodson
 Dan L. Dodson
 Reg. Surveyor 4270
 Ballatareina, Ohio