


4/17/48

E. Love,
C. Keyser,
D. Dobson.

78

Survey Old Midway Place.

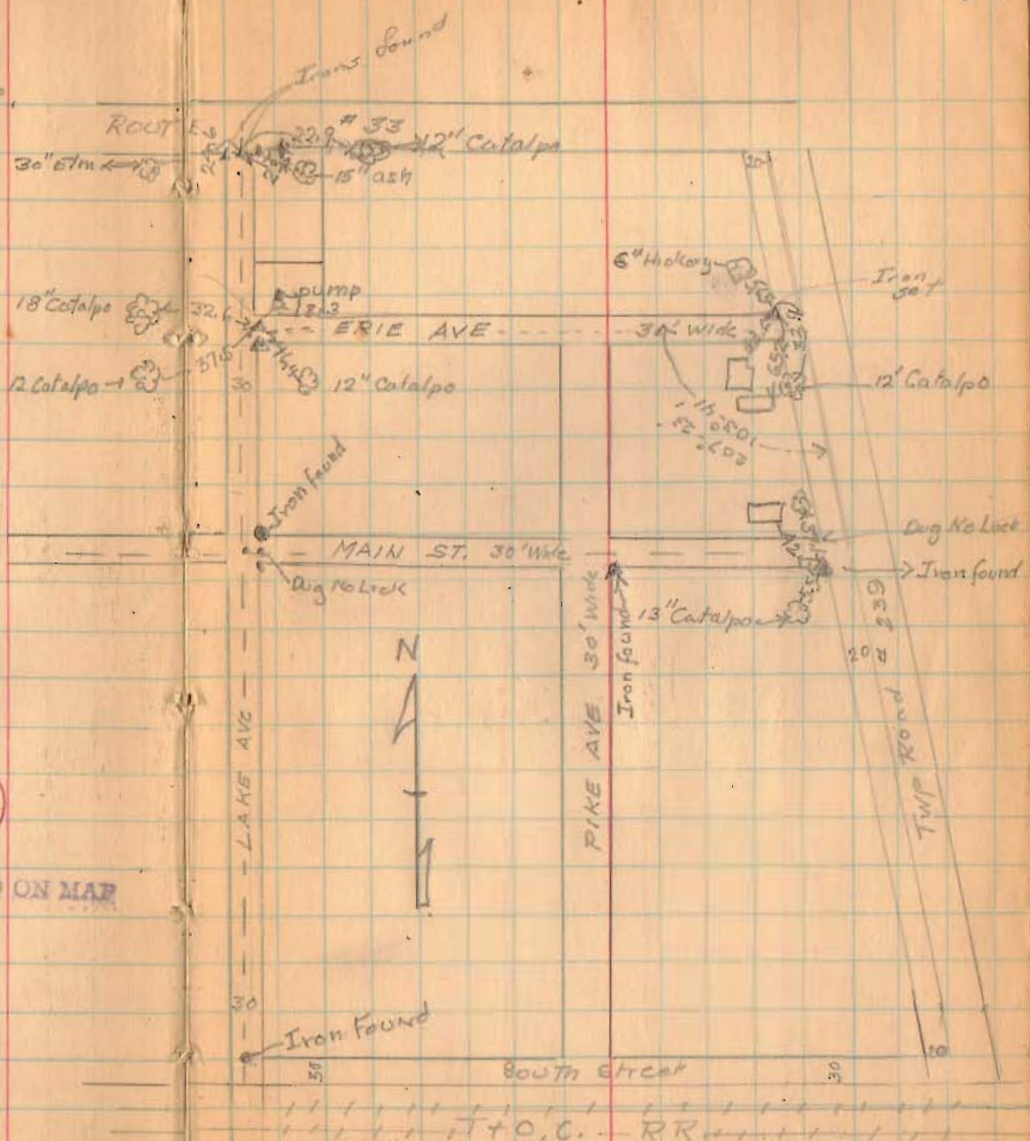

4427

INDEXED ON MAP