

PARK LOT SURVEY
SHAWNEE ISL.


- A = 3/4" pipe found
 B = " " "
 C = " " "
 D = 1" ϕ Bar Set - Found "D" hole ok
 E = St. fence post ok for line & dist.

See Karns Survey 3984 Dr. R.
 " " " 4492 " "
 " Lot 7 Survey 2483 Dr. R.

Dodson
 L. Cassin
 C. Nichols
 D. Brooks

5/19/70
 70°

48

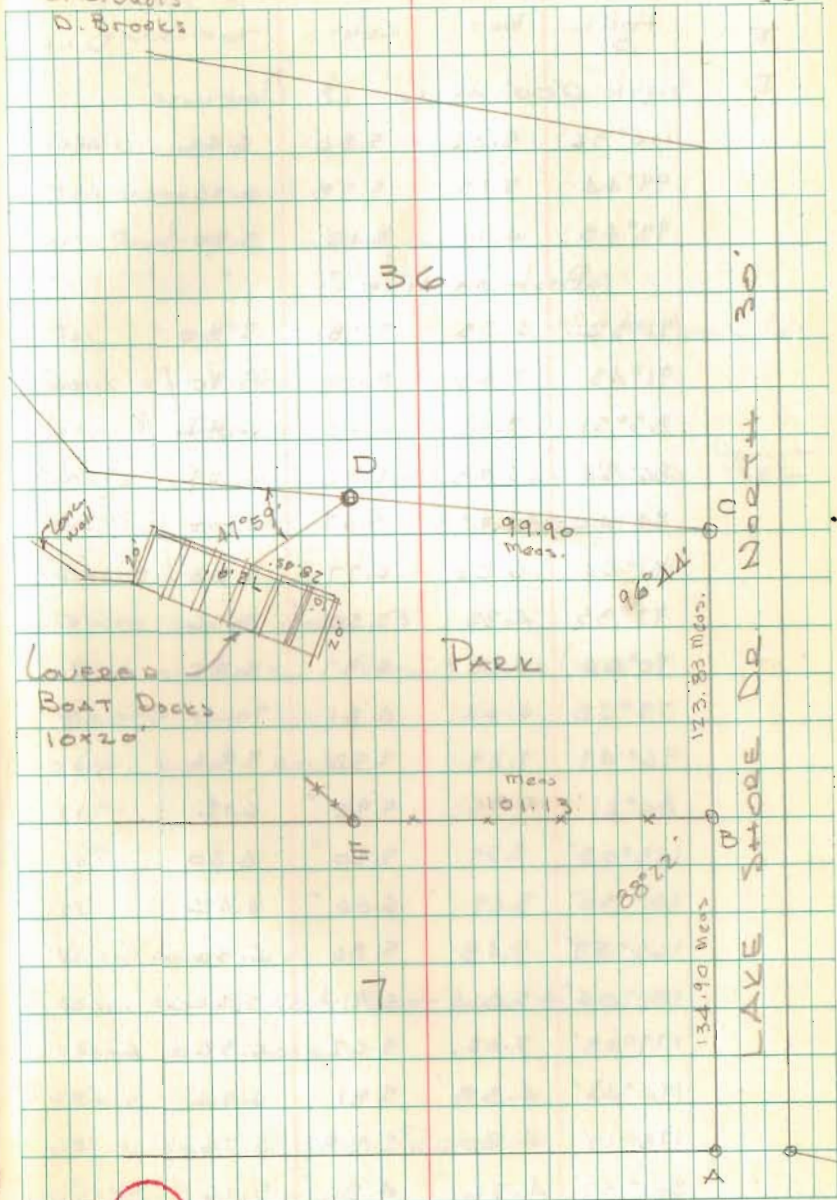

4901