




KICKAPOO PATH - 35'
N. 62°30' W.

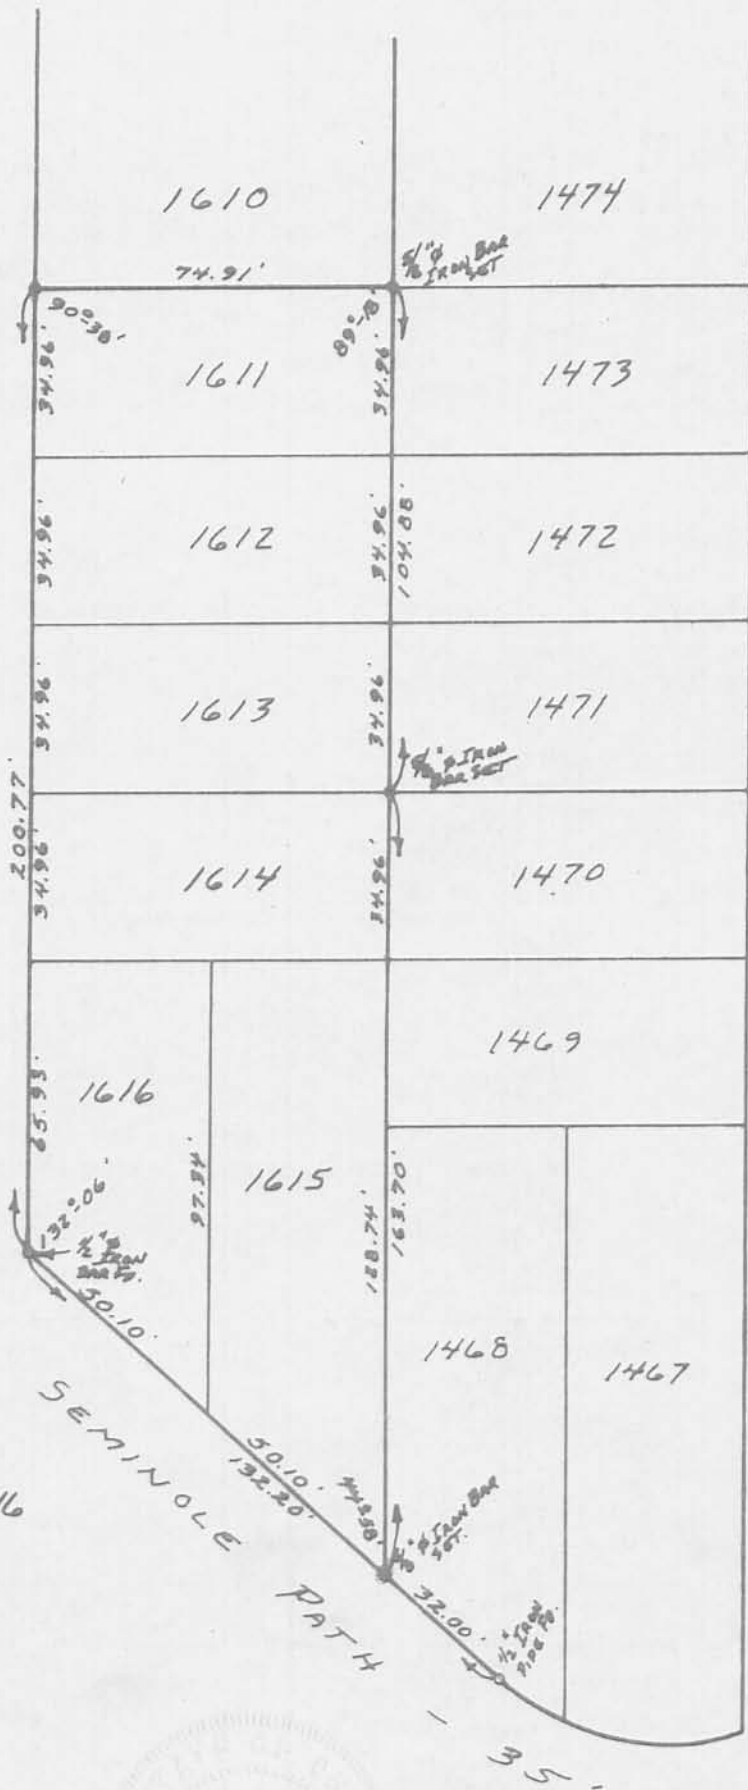

CHICKASAW PATH - 35'

SURVEY OF LOTS 1611-1616
CHIPPEWA PARK No. 3
STOKES TOWNSHIP
LOGAN COUNTY, OHIO
SEPTEMBER 22, 1973
SCALE: 1" = 40'

SURVEYED AND PLATTED BY:
DANIEL E. GILBEAT, P.S.
REG. SUR. No. 5402
1041 N. MAIN ST.
BELLEFONTAINE, OHIO 43311



5458 1P

INDEXED ON MAP