


WISE ALLOTMENT OF ISLAND VIEW

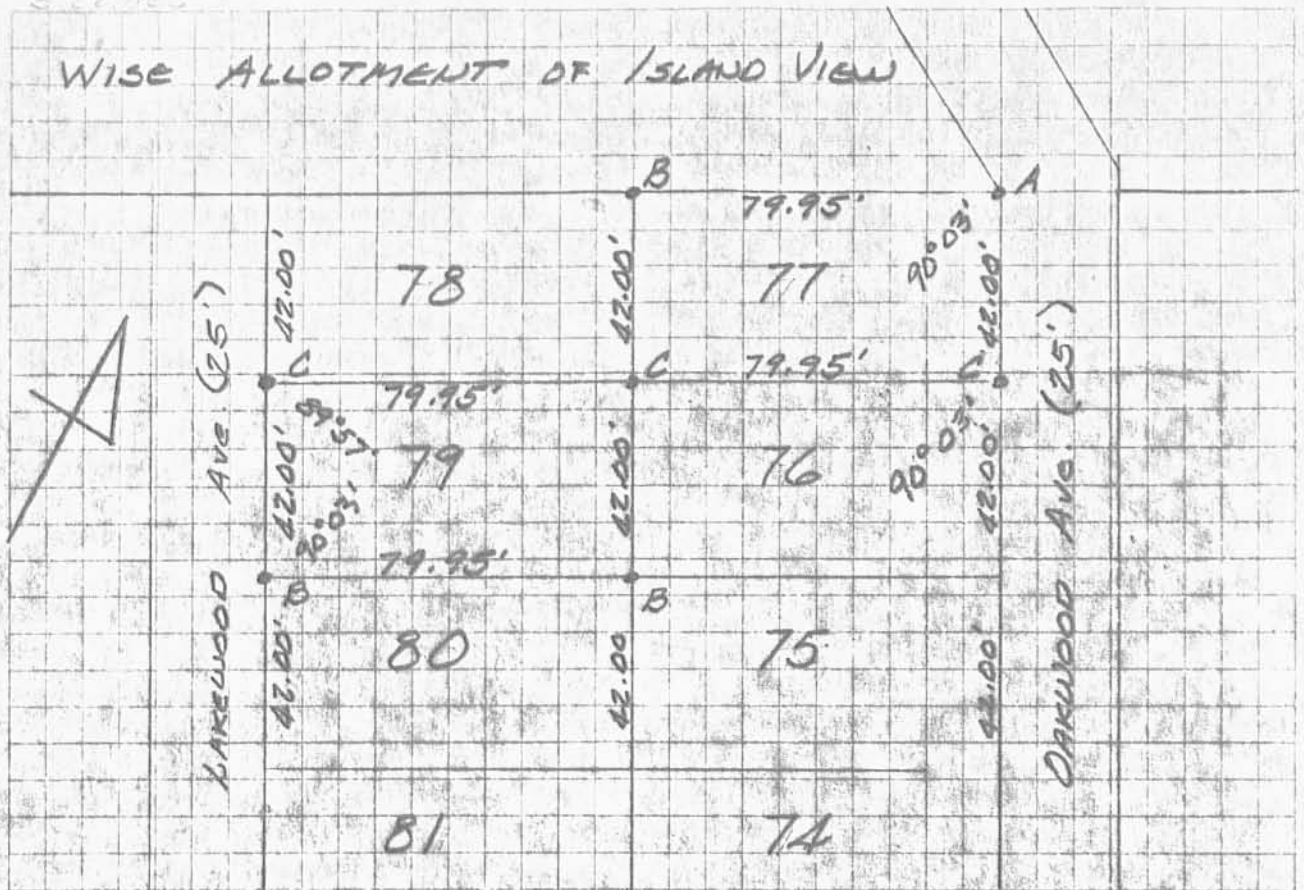

- A = L.P. SPK
- B = 5/8" ϕ BAR
- C = 3/4" ϕ BAR

SURVEY OF LOTS 77 & 79
 NICHOLSON'S ISLAND VIEW ALLOTMENT
 LOGAN COUNTY, OHIO
 JUNE, 1975

(5784) 1P

INDEXED ON MAP

LESLIE H. GESSUM
 REG. SURVEYOR 5248
 RUSHSVLVANIA, OHIO