




CHICKASAW PATH - 35'

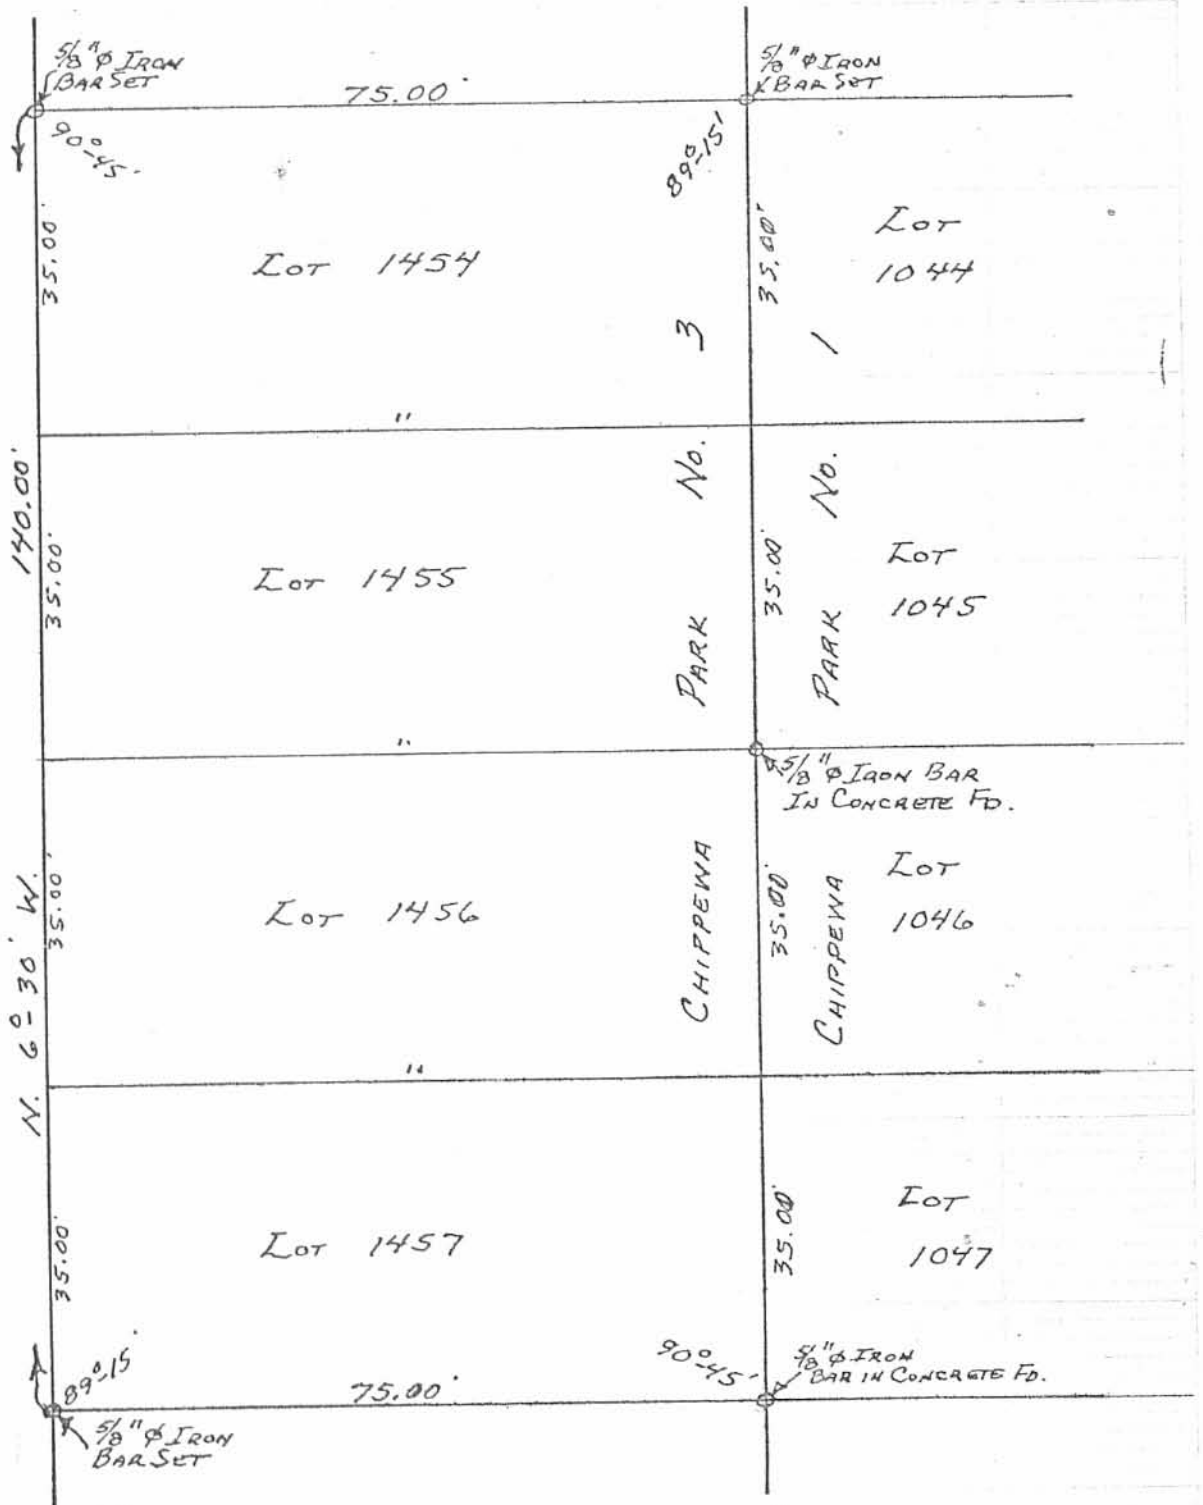

5935 IP

INDEXED ON MAP

SURVEY OF
 LOTS 1454, 1455, 1456, 1457
 CHIPPEWA PARK No. 3
 STOKES TOWNSHIP
 LOGAN COUNTY, OHIO
 AUGUST 21, 1976

SCALE: 1"=20'

SURVEYED AND PLATED BY:
 DANIEL E. GILBERT, P.S.
 REG. SUR. NO. 5402
 1041 N. MAIN ST.
 BELLEFONTAINE, OHIO 43311

REV'D 4-19-07 SMJ OK

