


Justin Kin Survey

The following described real estate situated in the Township of Stokes, County of Logan, State of Ohio and being a part of Virginia Military Survey No. 12276 and being Lot No. 2367 and 25.00 feet off the north ends of Lots 2365 and 2366 of Chipewa Park No. 3.

I hereby certify that this is a true and accurate description of a survey made by me on August 5, 1978.


Daniel E. Gilbert

Daniel E. Gilbert, P.S.
Reg. Sur. No. 5402
1041 N. Main St.
Bellefontaine, Ohio 43311

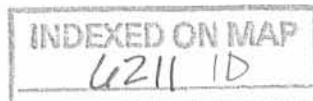



KOOTENAY PATH - 35

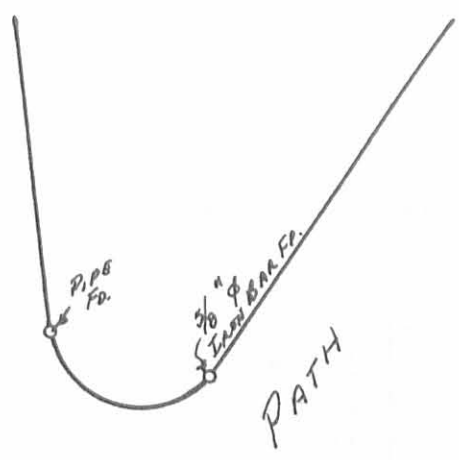

SEMINOLE PATH

X - IRON PIPES SET.

6211 IP

INDEXED ON MAP

SURVEYED AND PLATTED BY:
DANIEL E. GILBERT, P.S.
REG. SUR. No. 5402
1041 N. MAIN ST.
BELLEFONTAINE, OHIO 43311

JUSTIN KIN SURVEY
LOTS 2365, 2366, 2367.
CHIPPEWA PARK No. 3
STOKES TOWNSHIP
LOGAN COUNTY, OHIO
AUGUST 5, 1978

SCALE: 1" = 30'