

Lot 41


Seminole Shores Subd #1

Plat Blk C Vol. 3 pg 33

Dodson  
Geolin

May 8, 1959

53

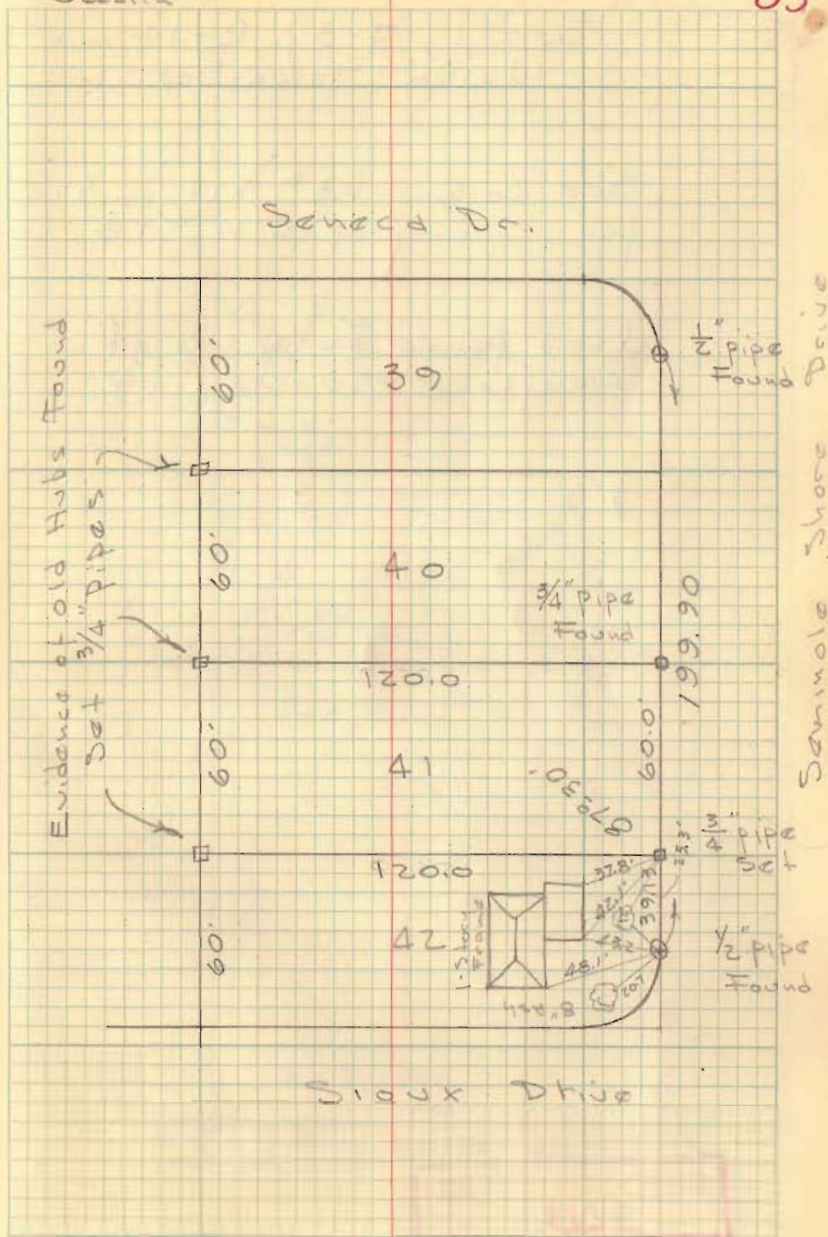

INDEXED ON MAP  
6397

