

SURVEYED AND PLATTED BY:
 DANIEL E. GILBERT, P.S.
 REG. SUR. NO. 5402
 1041 N. MAIN ST.
 BELLEFONTAINE, OHIO 43311


6512 1P

LOTS No. 100-101 SURVEY
 SUBDIVISION A
 SEMINOLE ISLAND
 STOKES TOWNSHIP
 LOGAN COUNTY, OHIO
 SEPTEMBER 20, 1980

SCALE: 1" = 20'

INDEXED ON MAP

EAGLE DRIVE - 30'

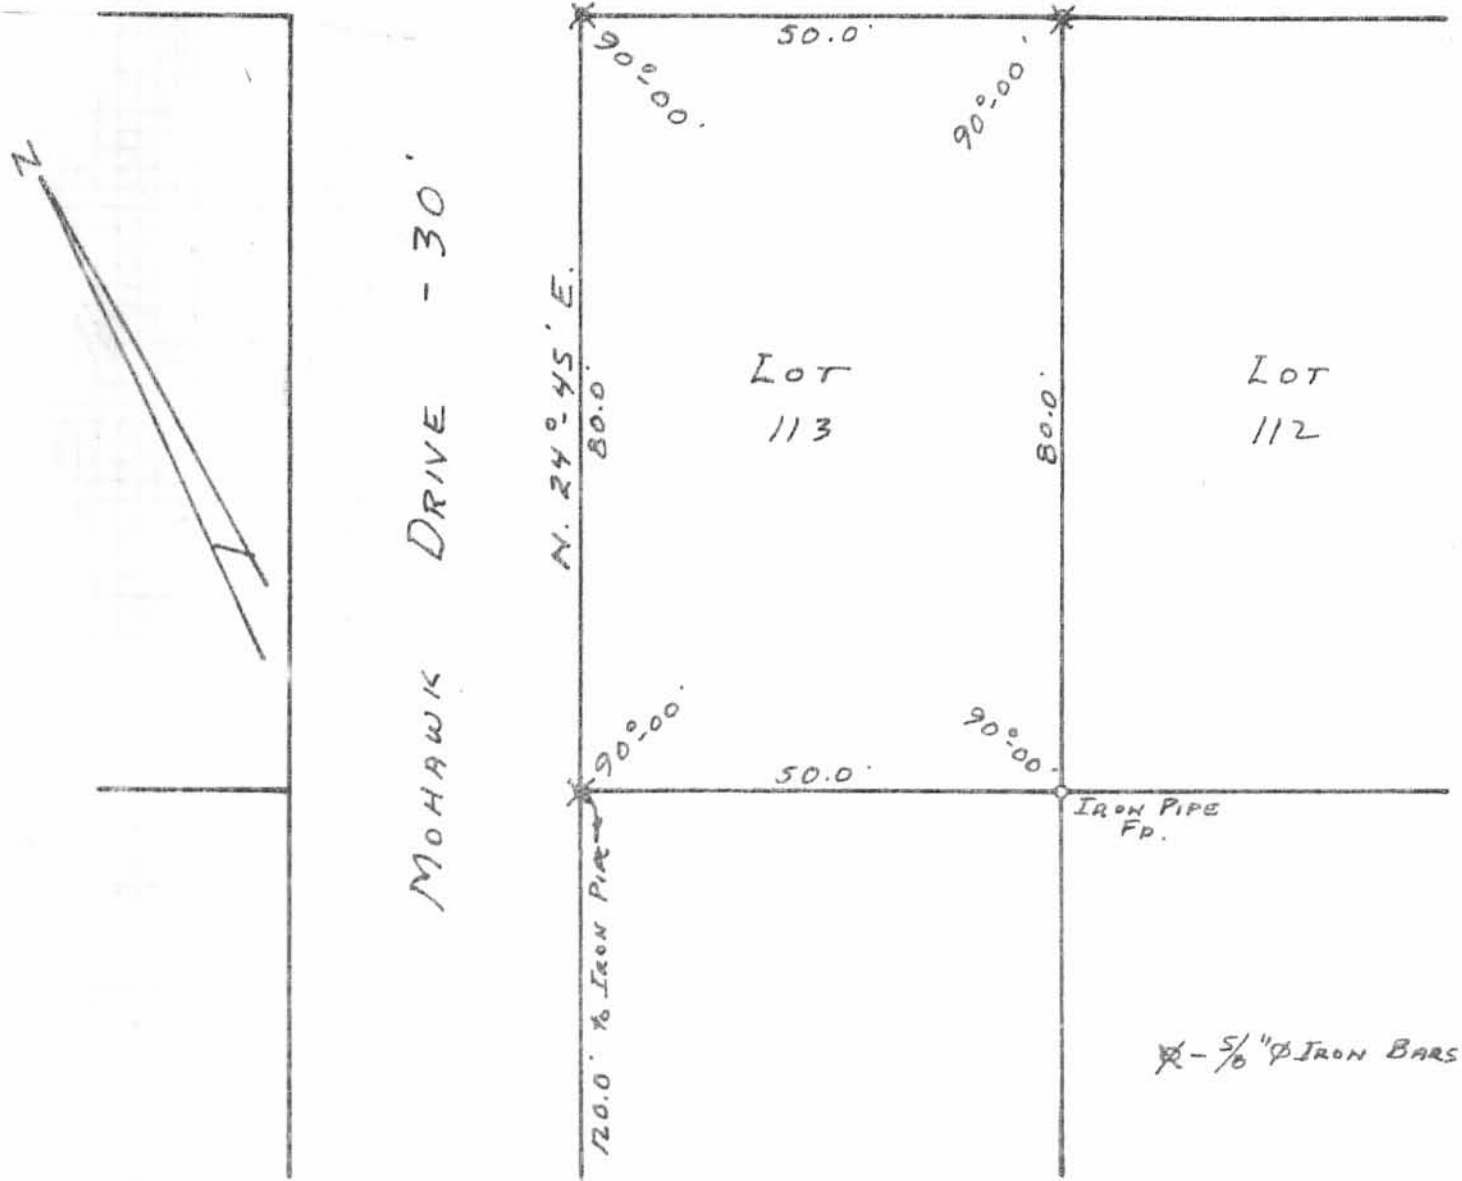

X - 5/8" Ø IRON BARS SET.

6512 2 P

INDEXED ON MAP

SURVEYED AND PLATTED BY:
 DANIEL E. GILBERT, P.S.
 REG. SUR. NO. 5402
 1041 N. MAIN ST.
 BELLEFONTAINE, OHIO 43311

LOT NO 113 SURVEY
 SUBDIVISION A
 SEMINOLE ISLAND
 STOKES TOWNSHIP
 LOGAN COUNTY, OHIO
 SEPTEMBER 20, 1980

SCALE: 1" = 20'