


7476

LESLIE H. GEESLIN
P. O. Box 274
RUSHSVLVANIA, OHIO 43347
(513) 468-2793

JOB SASSAFRAS POINT (SURVEY POINT RE)
STOKES TWP. (PLAT PAGE 37)
SHEET NO. V.M.S 12276 OF
LOGAN CO.
CALCULATED BY DATE
CHECKED BY DATE
SCALE Drawn BY: D.H.G. 1-24-86

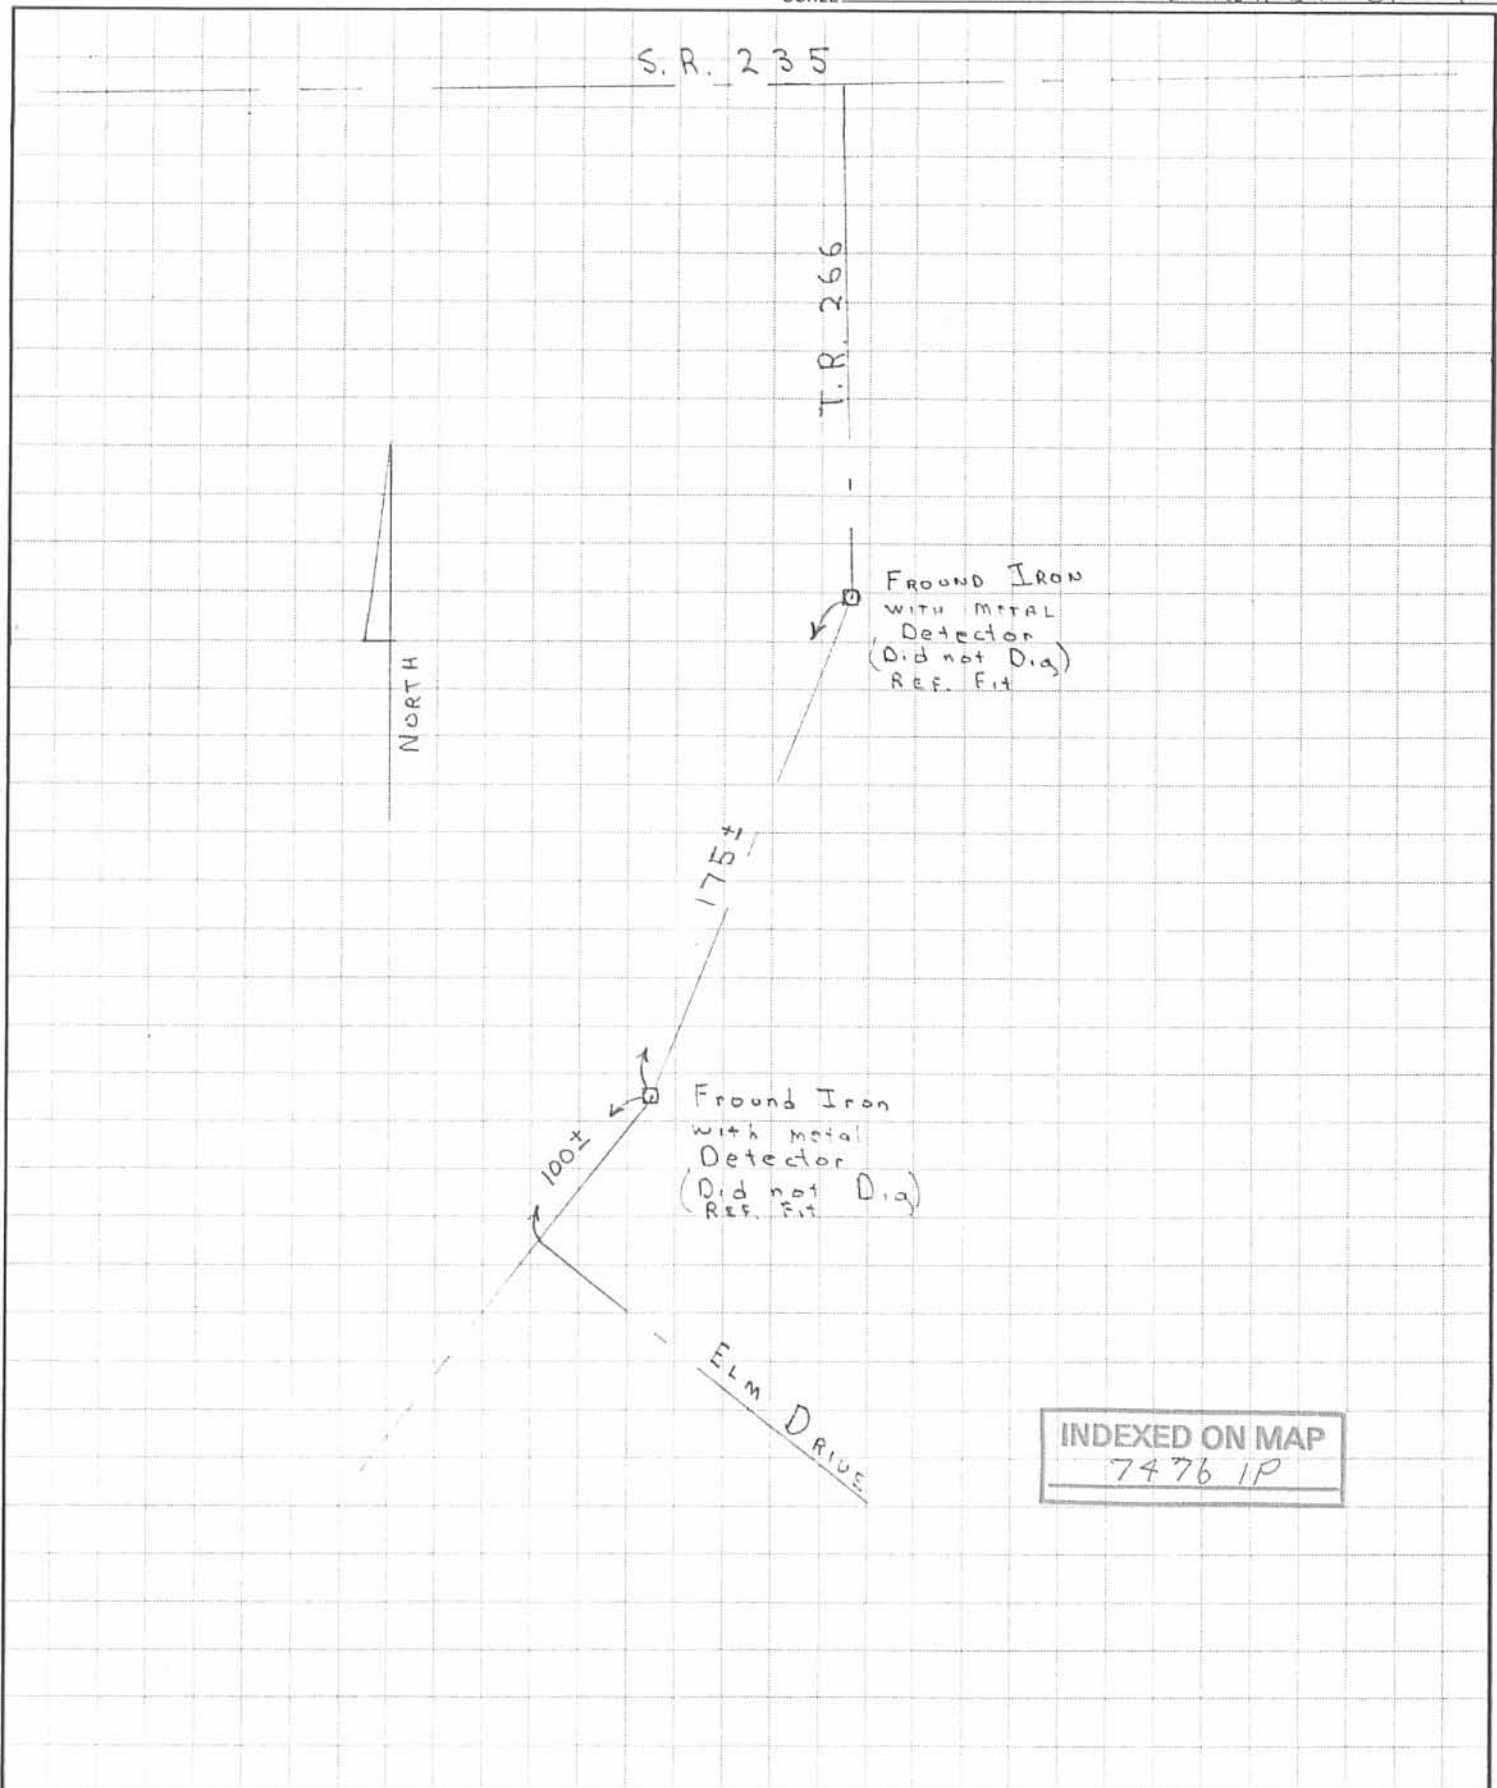

INDEXED ON MAP
7476 IP