

7477


LESLIE H. GEESLIN  
P. O. Box 274  
RUSHSVLVANIA, OHIO 43347  
(513) 468-2793

JOB - TURKEY FOOT ROAD (T.R. 293)  
STOKES TWP. (PLAT PAGE 36)  
SHEET NO. U.M.S. 12277 (SURVEY OF POINT REPLACEMENT)  
LOGAN CO.

CALCULATED BY \_\_\_\_\_ DATE \_\_\_\_\_


CHECKED BY \_\_\_\_\_ DATE 1-24-56

SCALE \_\_\_\_\_ DRAWN BY: D.L.G.

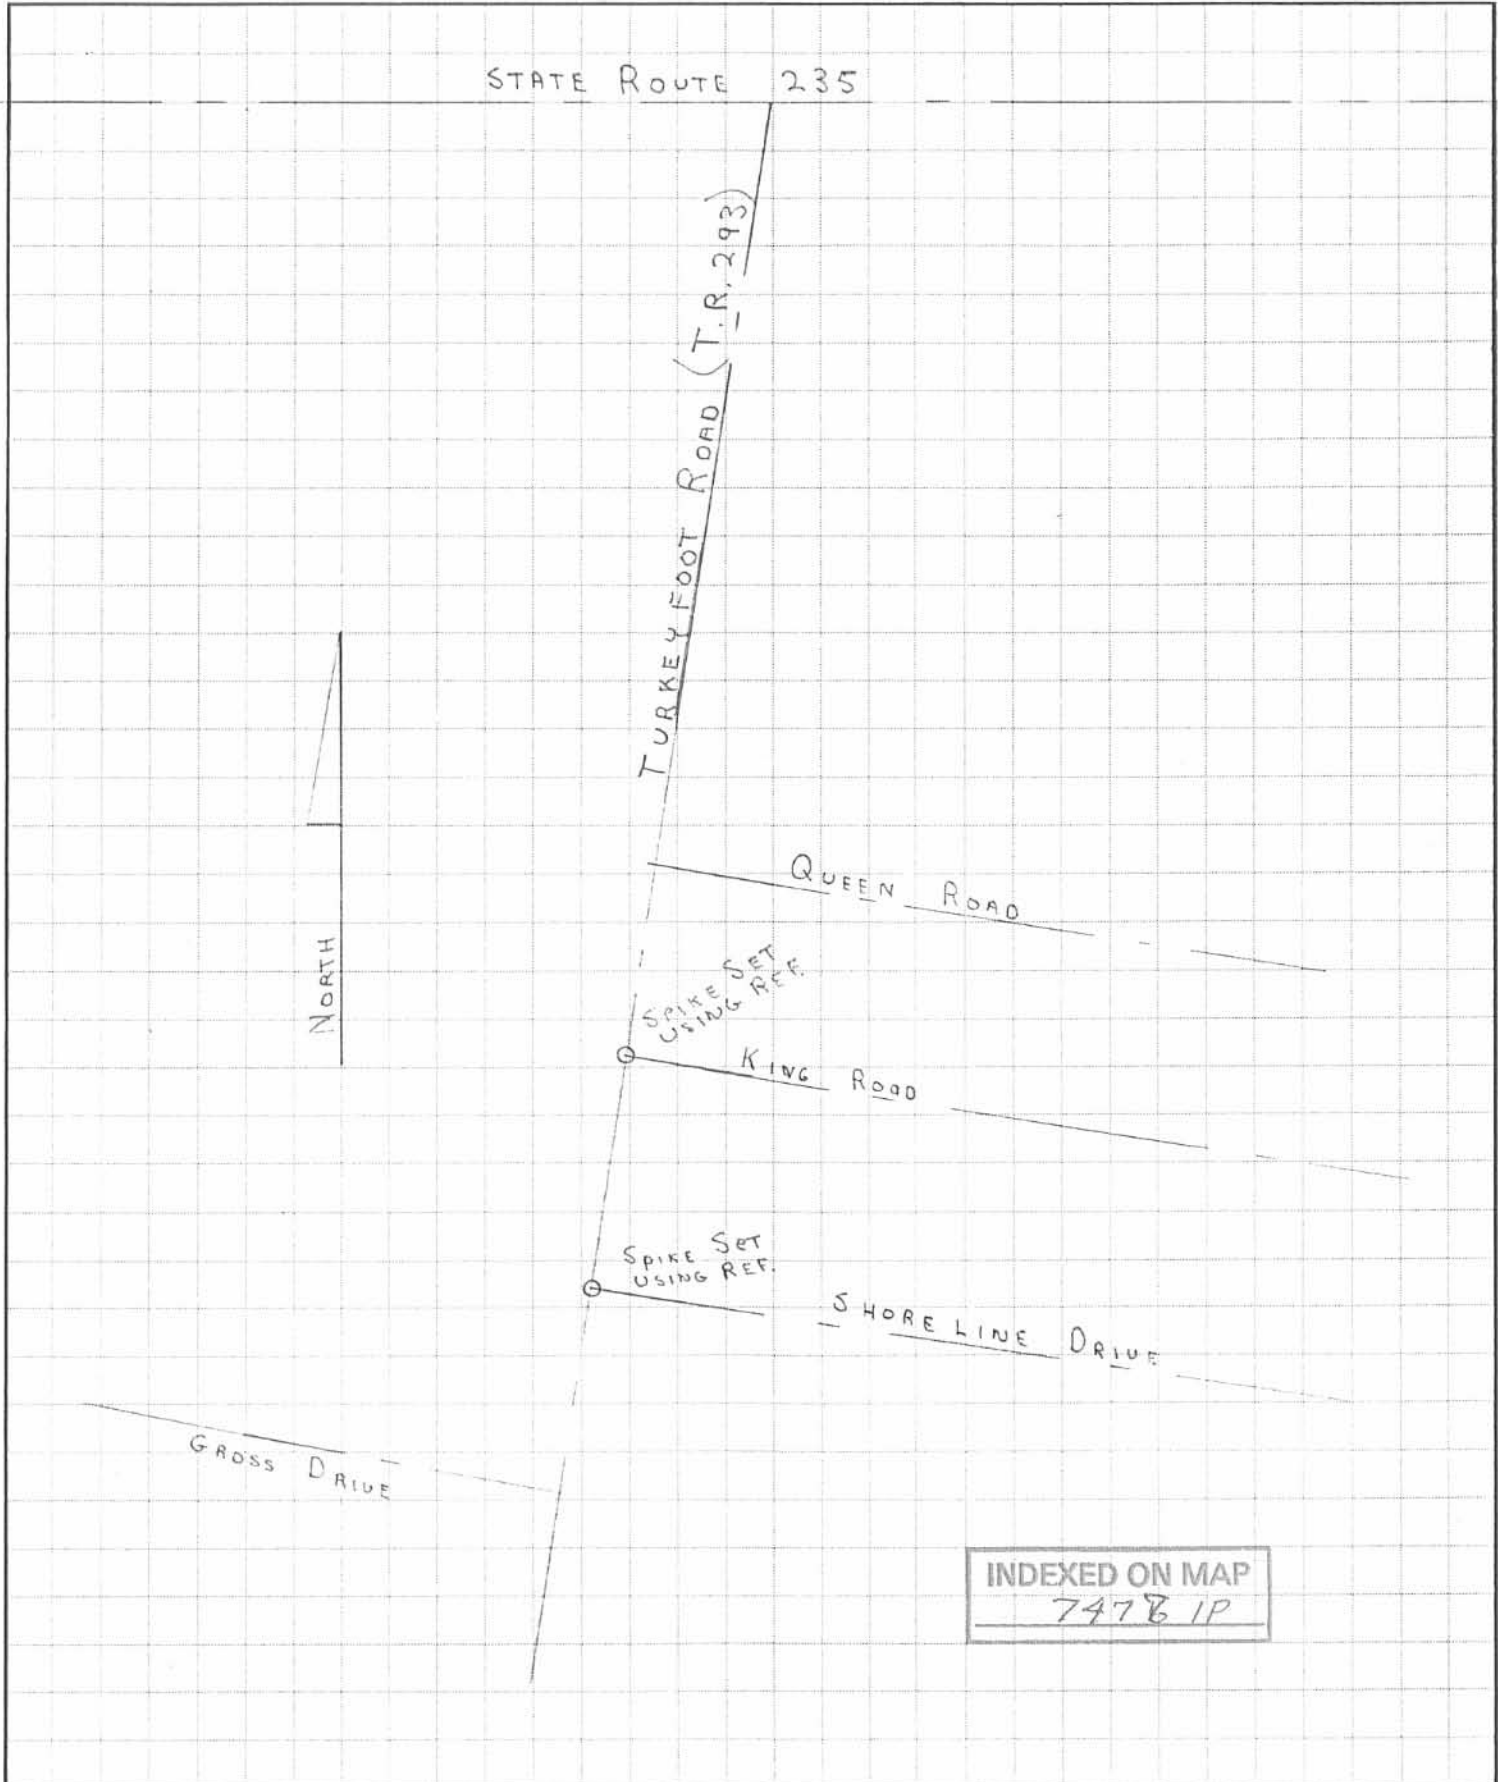

LESLIE H. GEESLIN  
P. O. Box 274  
RUSHSVLVANIA, OHIO 43347  
(513) 468-2793

JOB TURKEY FOOT POINT (SURVEY POINT RE)  
STOKES TWP. (PLAT PAGE: 66)  
SHEET NO. V.M.S. 12276 + 12277 OF \_\_\_\_\_  
LOGAN CO.  
CALCULATED BY \_\_\_\_\_ DATE \_\_\_\_\_  
CHECKED BY \_\_\_\_\_ DATE 1-24-86  
SCALE \_\_\_\_\_ DRAWN BY: D.L.G.

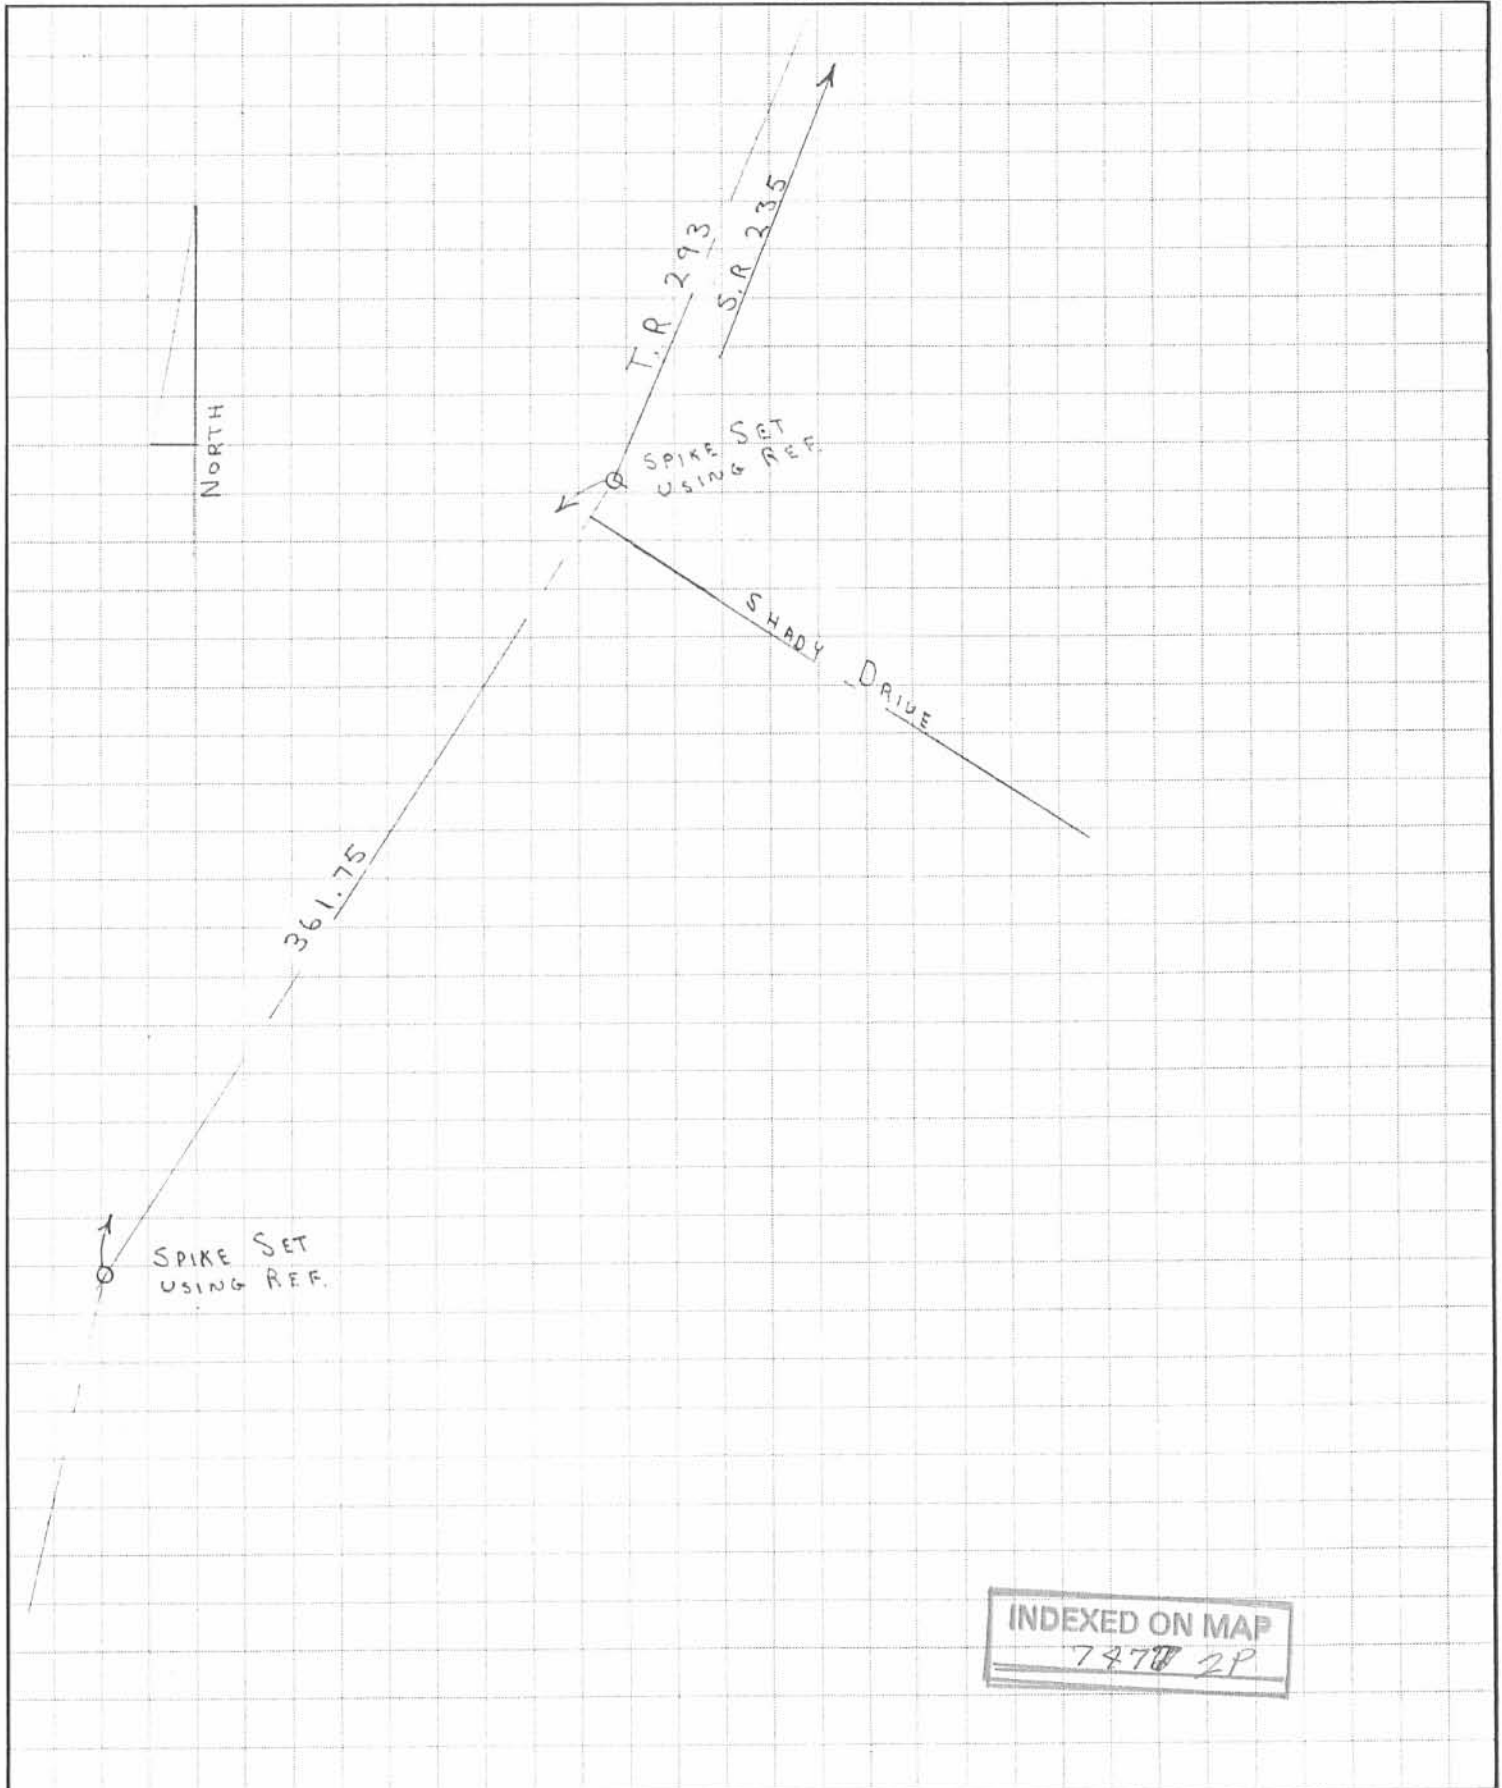

INDEXED ON MAP  
7478 2P