


Survey in
SW $\frac{1}{4}$ Sec 9
T6S-R8E
Stokes Twp.
Logan Co., Ohio

The following described parcel of land is situated in the Southwest quarter, Section nine Township six South - Range eight East, Stokes Township, Logan County, Ohio, and is more particularly described as follows:

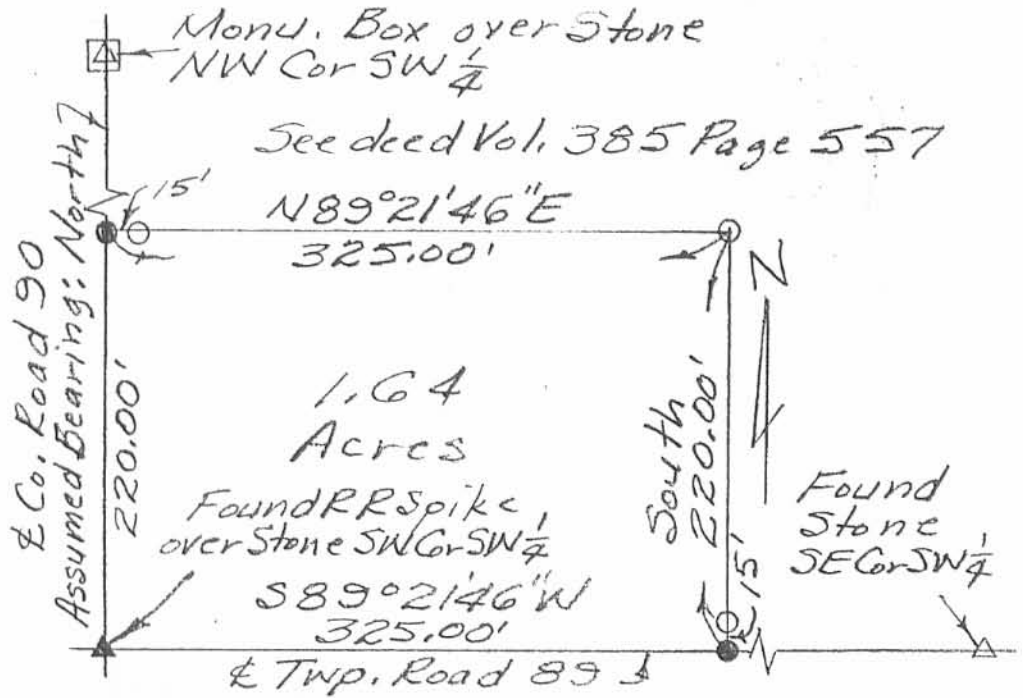

Beginning at a Railroad spike found over the stone at the Southwest corner of said quarter at the intersection of County Road 90 and Township Road 89; thence North (assumed bearing) on the West line of said quarter and the centerline of County Road 90 two hundred twenty (220.00) feet to a PK nail set; thence North eighty-nine degrees twenty-one minutes forty-six seconds East (N89°21'46"E) (passing through a $\frac{1}{2}$ " re-rod set at 15') three hundred twenty-five (325.00) feet to a $\frac{1}{2}$ " re-rod set; thence South, parallel with the West line (passing through a $\frac{1}{2}$ " re-rod set at 205') two hundred twenty (220.00) feet to a PK nail set on the South line of said quarter and the centerline of Township Road 89; thence South eighty-nine degrees twenty-one minutes forty-six seconds West (S89°21'46"W) on the South line of said quarter and the centerline of Township Road 89 three hundred twenty-five (325.00) feet to the place of beginning containing one and sixty-four hundredths (1.64) acres, more or less, subject to legal highway and all easements and restrictions of record.

All $\frac{1}{2}$ " re-rods set and called for above are topped with a plastic Permark cap stamped: LS 5772.

This description and plat represents a survey made under my supervision on November 21, 1984, and all markers set and called for above are in place.

INDEXED ON MAP
7564 1P

George E. Woolley



LEGEND

- = PK Nail w/ Surveyor's Tag Set
- = $\frac{1}{2}$ " Re-rod w/ Permark Cap Set

| | | | |
|------------------------------|----------|------------------------|----------|
| ACCU-TRACE LAND SURVEYS INC. | | | |
| George E. Woolley | | Reg. Surveyor No. 5772 | |
| Ken & Cheryl Lucas | | | |
| SURVEYED BY | DATE | DRAWN BY | DATE |
| J.C.W. | 11-21-84 | AEW | 11-21-84 |
| SCALE | APP'D | DRWG. NO. | |
| 1" = 100' | | | |