


WALNUT ST. - 40'

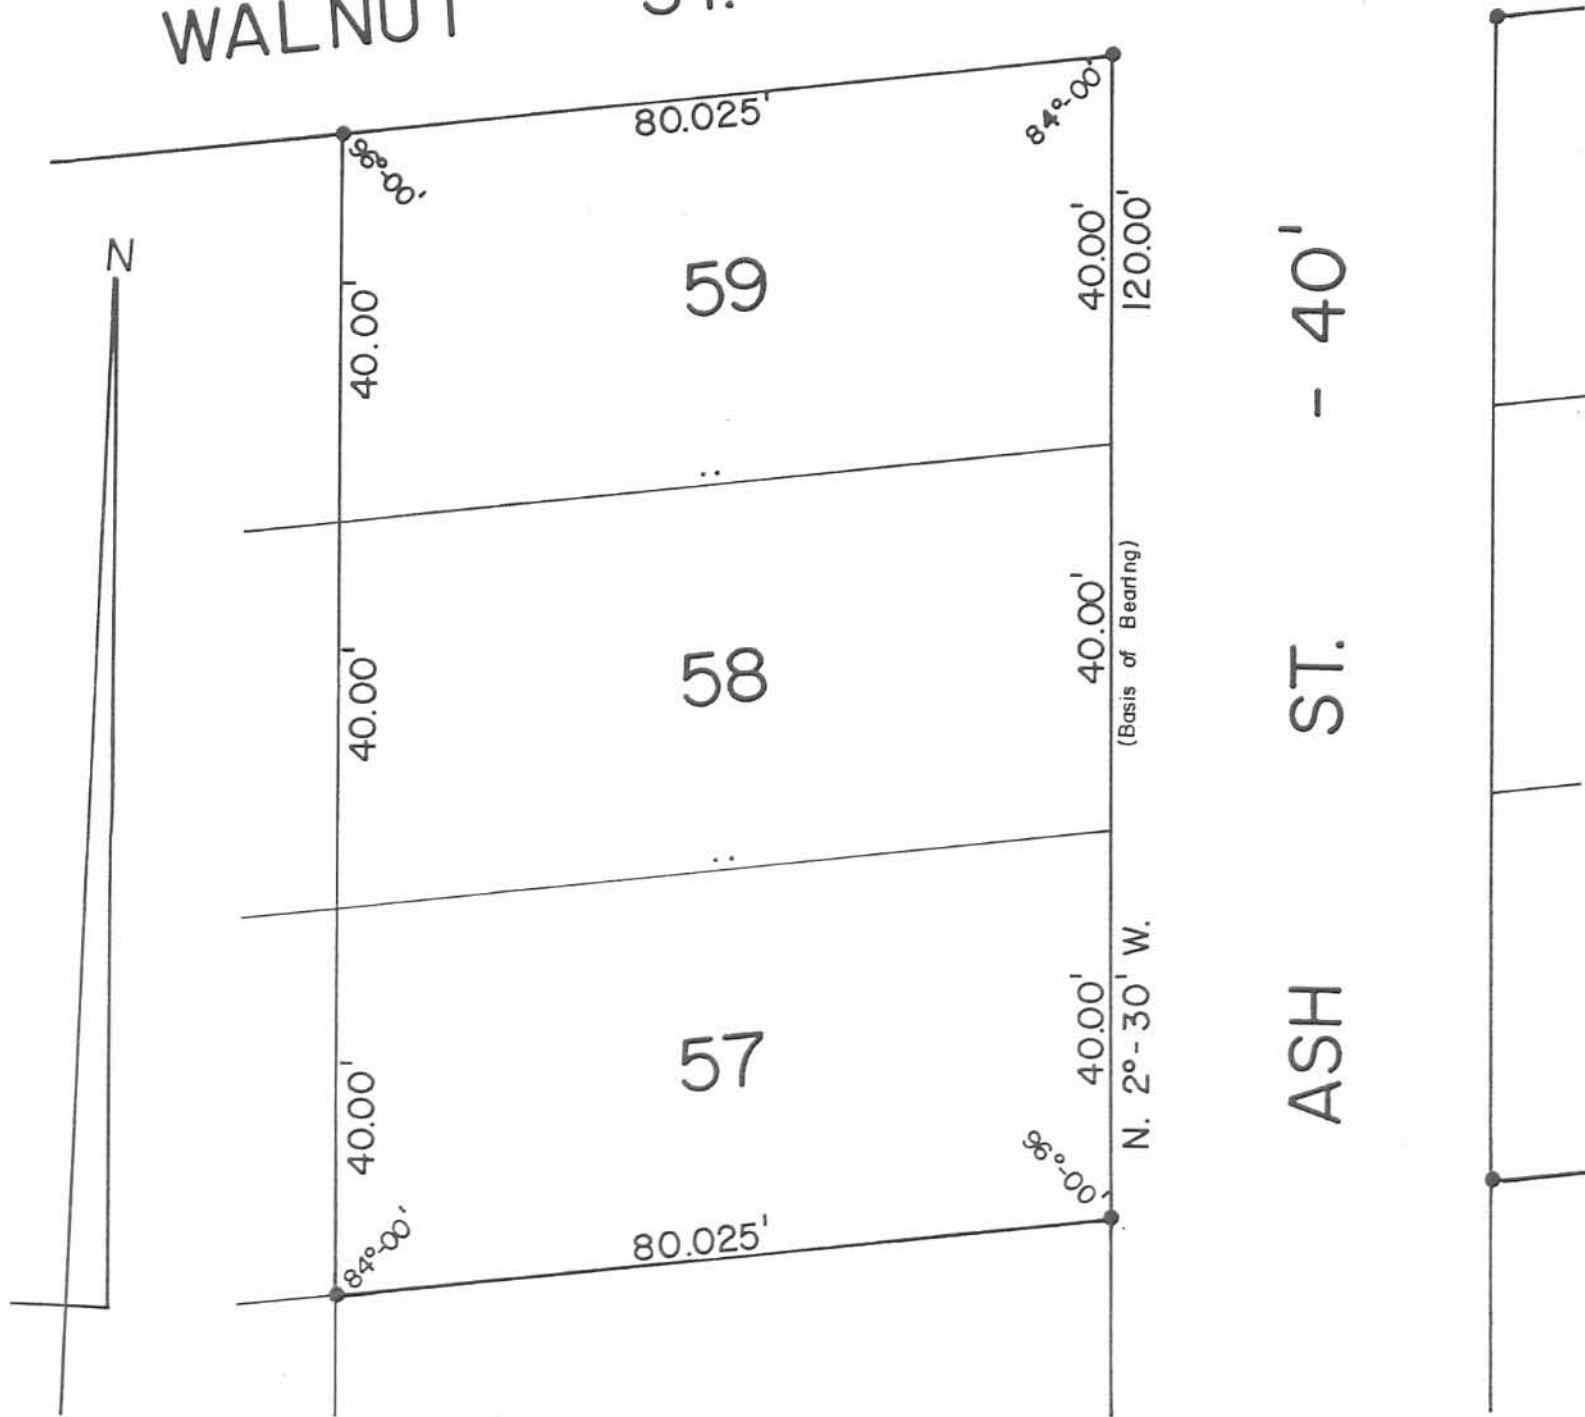

• - 5/8" x 30" Rebars Fd & Set.

INDEXED ON MAP
7957

IP

Daniel E. Gilbert
 Daniel E. Gilbert, P.S.
 Reg. Sur. No. 5402
 400 North Park Street
 Bellefontaine, Ohio
 43311



Survey of Lots 57, 58, 59
 Avondale Park Allotment No. 2
 Stokes Township
 Logan County, Ohio
 October 13, 1989
 Scale: 1" = 20'

089-065