

LEININGER SURVEY

The following described real estate situated in the Township of Stokes, County of Logan, State of Ohio and being a part of the North Half of the East Half of the Northeast Quarter of Section No. 33, Town 6 South, Range 8 East and being out of the north side of Everett Leininger's present 37.64 Acre tract as described in Deed Volume No. 236 Page 54 (4-5-1956) and being more particularly described as follows:

Beginning for reference at a R. R. Spike set at the intersection of the centerlines of C. H. No. 82 and C. H. No. 83 and being the northwest corner to Leininger's tract and being on the north line of Section No. 33 and the south line of Section No. 28;

Thence with the centerline of C. H. No. 82, which is also the line between said Sections, N. 84°45'00" E. 430.13 feet to a R. R. Spike set for the true place of beginning for this survey (Note: This line is the Basis of Bearing for this survey);

Thence continuing with said centerline and Section Line, N. 84°45'00" E. 210.00 feet to a R. R. Spike set;

Thence S. 5°15'00" E. 207.50 feet to a 5/8" x 30" Rebar set, passing through a 5/8" x 30" Rebar set at 30.00 feet;

Thence S. 84°45'00" W. 210.00 feet to a 5/8" x 30" Rebar set;

Thence N. 5°15'00" W. 207.50 feet to the true place of beginning, passing through a 5/8" x 30" Rebar set at 177.50 feet, containing 43,575.00 square feet or 1.000 Acres, more or less.

Of the above described tract, there is 6,300.00 square feet or 0.145 Acres in the right of way of C. H. No. 82.

I hereby certify that this description is the result of a field survey made by me on August 15, 1990.



Daniel E. Gilbert
DANIEL E. GILBERT, P.S.
Reg. Sur. No. 5402
400 N Park St.
Bellefontaine, Ohio
43311

INDEXED ON MAP
8067

LD

T.R. No. 83

Section No. 28 T.6S. R.8E.

Section

Line


N. 84°-45'-00" E.

C. H. No. 82 - 60'

430.13'

Basis of Bearing

Section No. 33 T.6S. R.8E.

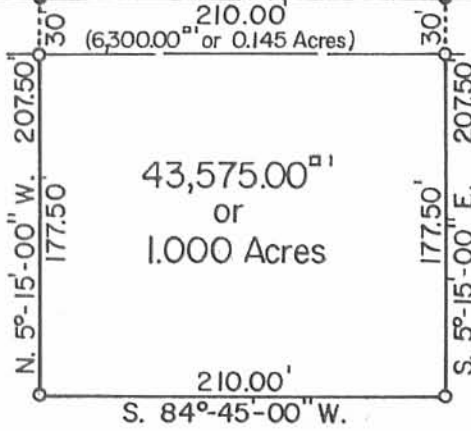

Everett Leininger et ux

Vol. 236 P. 54 (4-5-1956)
Vol. 327 P. 744 (10-4-1969)

Per. Par. No. 43-016-00-00-030000

37.64 Acres

- - R. R. Spikes Set.
- - 5/8 x 30 Rebars Set.

Reference:

C. H. No. 82
F. B. No. 320 P. 6-7.

C. H. No. 83 - 40'
N. 5°-44'-00" W.

INDEXED ON MAP
3067

LEININGER SURVEY
Part of the N 1/2 of E 1/2 of NE 1/4
of
Section No. 33 T.6S. R.8E.
Stokes Township
Logan County, Ohio
August 15, 1990

Daniel E. Gilbert

Daniel E. Gilbert, P.S.
Reg. Sur. No. 5402
400 N. Park St.
Bellefontaine, Ohio
43311



Scale: 1" = 100'

090-042