


1" Iron Pipe Fd.
Point "K"
FB. No. 704 Page 1.

ASH AVENUE - 30' (T.R. No. 260)

COTTONWOOD AVENUE - 15'

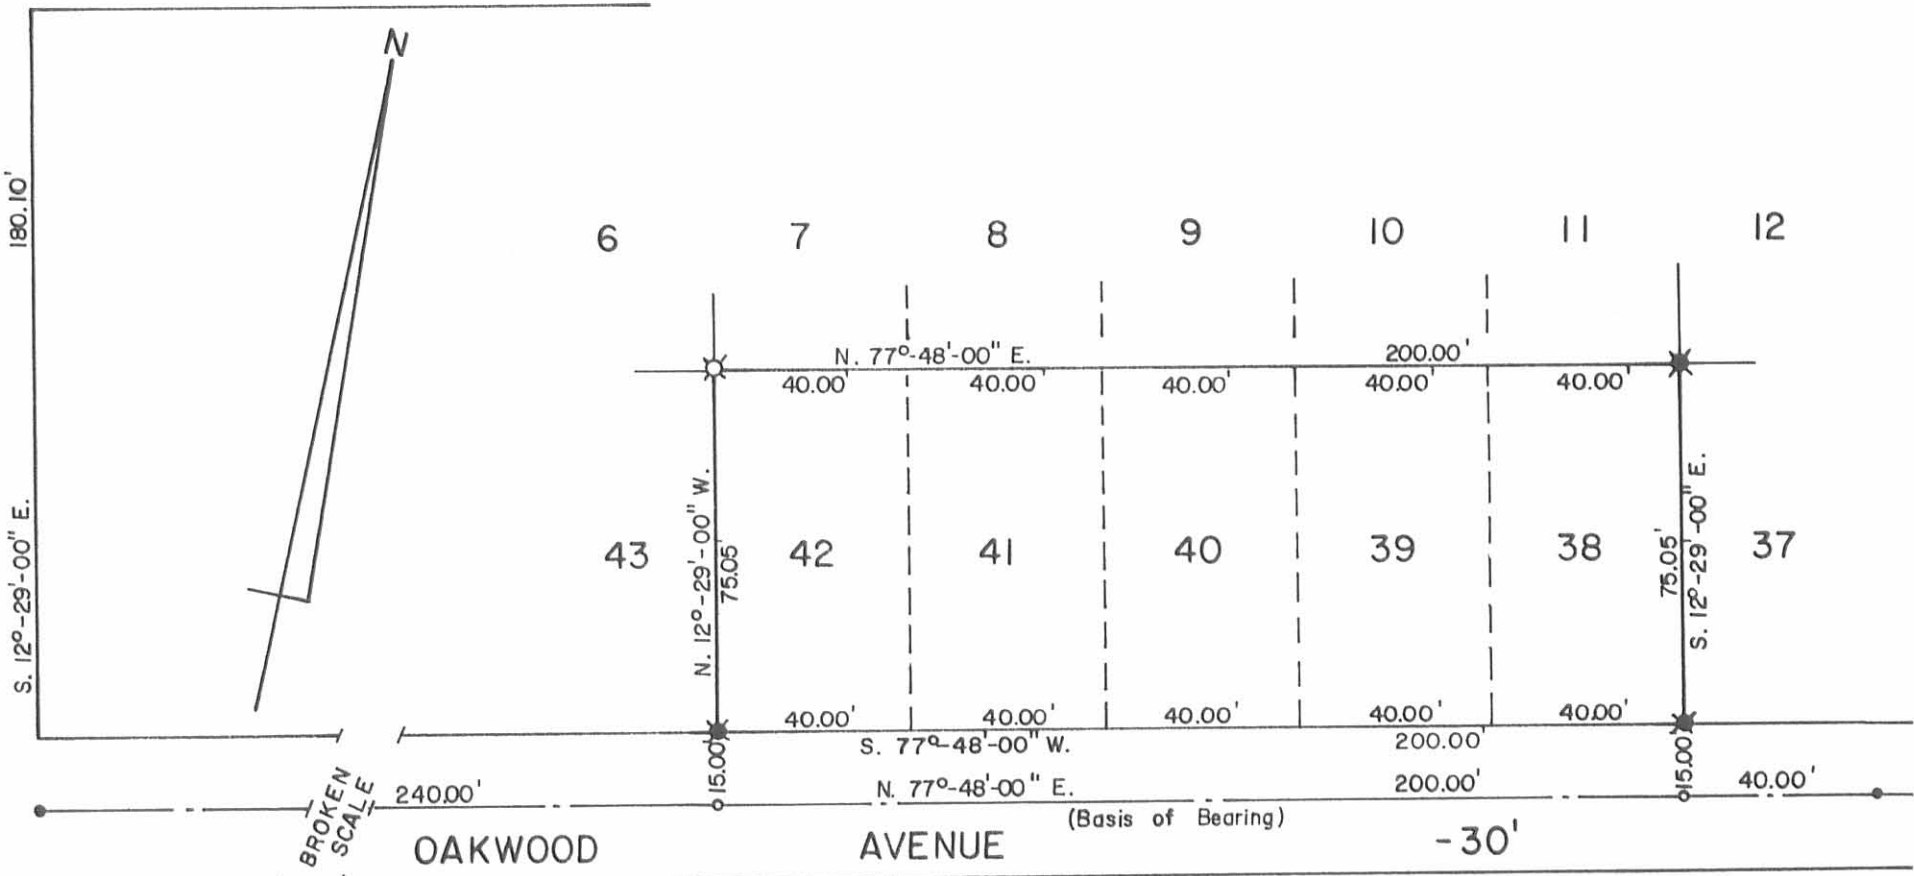


- - P.K. Nails Fd.
- - P.K. Nails Set.
- ⊙ - Iron Bar, Fd. (Lee)
- - 5/8 x 30 Rebars Set.

Reference:
Wise Allotment of Island View.
Plat Cab. A Slide 193.

OLIVER SURVEY
Lots No. 38, 39, 40, 41, 42
WISE ALLOTMENT
of
ISLAND VIEW
Stokes Township
Logan County, Ohio
January 19, 1991



INDEXED ON MAP
8096

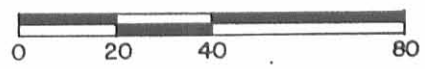

Scale: 1" = 40'

091-001

Daniel E. Gilbert
Daniel E. Gilbert, P.S.
Reg. Sur. No. 5402
400 N. Park St.
Bellefontaine, Ohio 43311