


1 REC D 39 95

SCALE: 1" = 30'

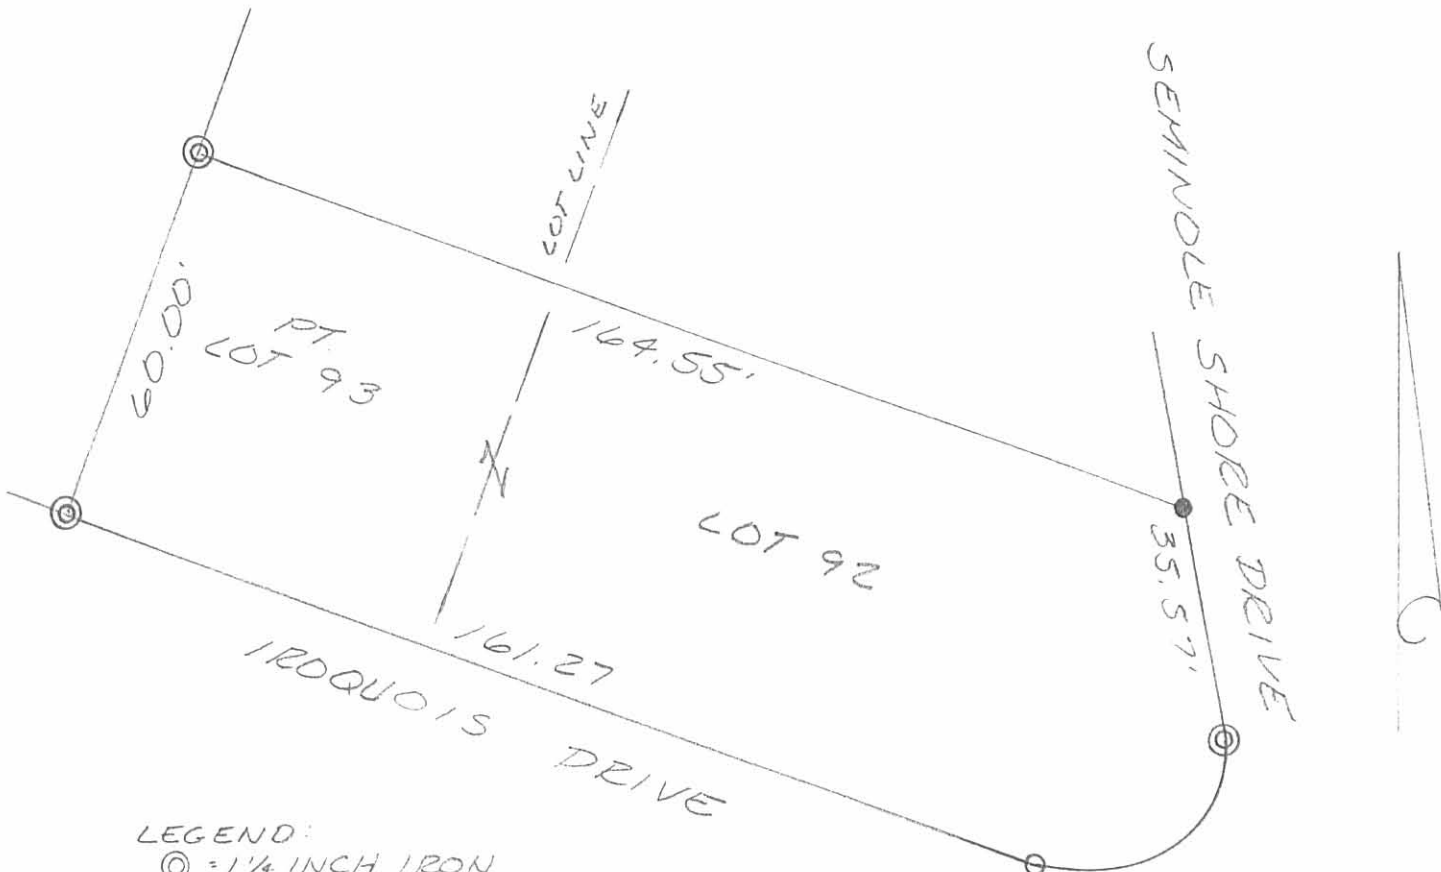

LEGEND:

- ⊙ = 1/4 INCH IRON PIPE FOUND
- = 3/4 INCH IRON PIPE FOUND
- = 5/8 INCH IRON BAR FOUND

SURVEY OF LOT 92 AND PT. LOT 93  
 OF SEMINOLE ISLAND IN VIRGINIA  
 MILITARY SURVEY 12276,  
 STOKES TOWNSHIP, LOGAN COUNTY,  
 OHIO FOR CHRIS MILLER ON  
 MARCH 9, 1995



*Leslie H. Geeslin*  
 LESLIE H. GEESLIN  
 RUSHSVLVANIA, O  
 (513) 468-2793

INDEXED ON MAP  
 8992

1P