



REC'D 1-26-98 SWY

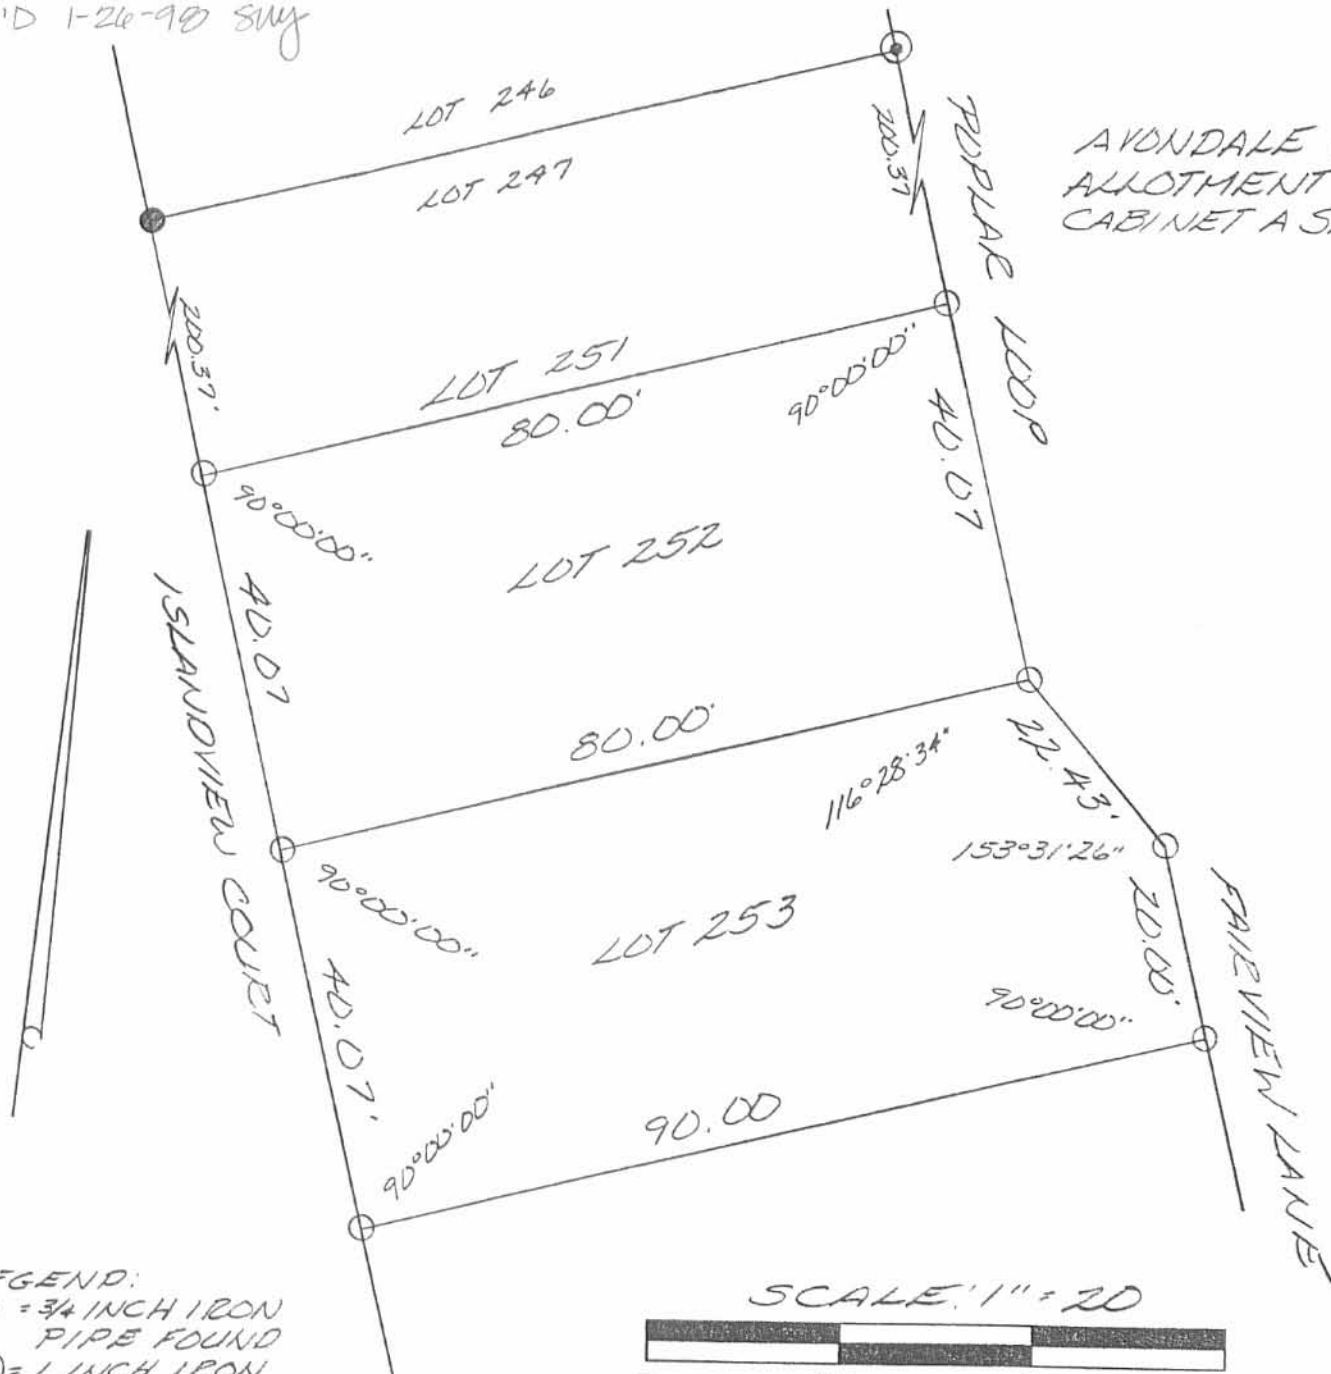

AVONDALE PARK ALLOTMENT NO. 3 CABINET A SLIDE 241

- LEGEND:
- = 3/4 INCH IRON PIPE FOUND
 - ⊙ = 1 INCH IRON PIPE FOUND
 - = 5/8 INCH IRON BAR SET

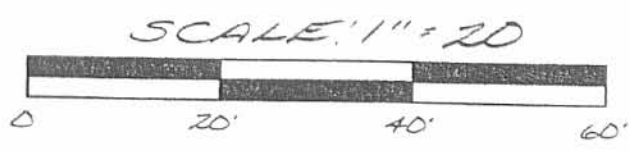

SURVEY OF LOTS 252 AND 253 OF AVONDALE PARK IN VIRGINIA MILITARY SURVEY 12276, STOKES TOWNSHIP, LOGAN COUNTY, OHIO FOR JIM BURNS ON JANUARY 23, 1997



INDEXED ON MAP
9178

IP
Leslie H. Geeslin
LESLIE H. GEESLIN
RUSHSVANIA, O
(937) 468-2793