

Sigafoss Survey
Union Twp.
sec. 8 T. 3 R. 14
(See Book 561 Page 61)

A. B. Barnes Deed Vol. 118 - Page 349

J. M. Sigafoss Deed Vol. 86 Page 100

Mary E. Culberson Deed Vol. 100 Page 174

A - Stone found N.W. cor. of NE. qr sec 8.

B - Noted Iron Bar

C Line of fence

D Placed Iron on Line AG

E Placed iron on Line AG Hub 20' E. on Line ER.

F " " " " Hub 20' E on Line PI
Post 15' 2E on Line PI

G Iron Found

H. Stone S.W. cor. of S.W. qr sec 8 Level wt
Ground

I. Post SW cor. NE. qr sec. 8

J. Post

K Placed Iron 2nd Hub

L Post

$$GF = 264.3$$

$$FF = 398.0$$

$$ED = LIK = 181.0'$$

$$DC = 354.0'$$

$$DB = 457.0'$$

$$DA = 1734.0'$$

X - Iron found
Y - " 0.5' East of Line 57
Stationery measured Aug. 17-1936
F. W. Wright
G. W. Wright
H. W. Ewing




sec. 9 T. 3

Aug. 14-1936
F. W. Wright
W. R. Wright

R. 14

(See Book 561)
Page 61

2 Story
House
Markins

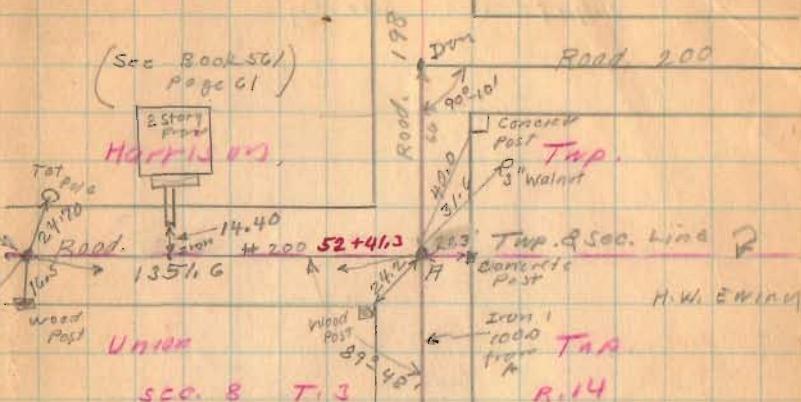

Milton Jacobs

~~39+64.3~~
Wood Post
Herman Sigenthaler

E.W. Ewing

~~38+61.3~~
A.B. Barnes

~~35+07.3~~

~~33+26.3~~

~~31+29~~

~~29+28.3~~

~~26+64~~

~~19.6~~

~~14.5~~

~~21.9~~

~~0+00~~

~~24.7~~

~~12.9~~

sec. 8 T. 3

Road. 43

sec. 7 T. 3

R. 14

Road. 43

R. 14 (over)

1736

INDEXED ON MAP

8-14-36

62

Sigefoods SURVEY



DLKE = 2.54 Acres

FEKI = 5.90 Acres


Present Duplicate
813 A.
2.54 TO Barns
5.90

New Survey
8.44
2.54 TO Barns
5.90

1736

INDEXED ON MAP

Survey
Foot
2 Story
Frame

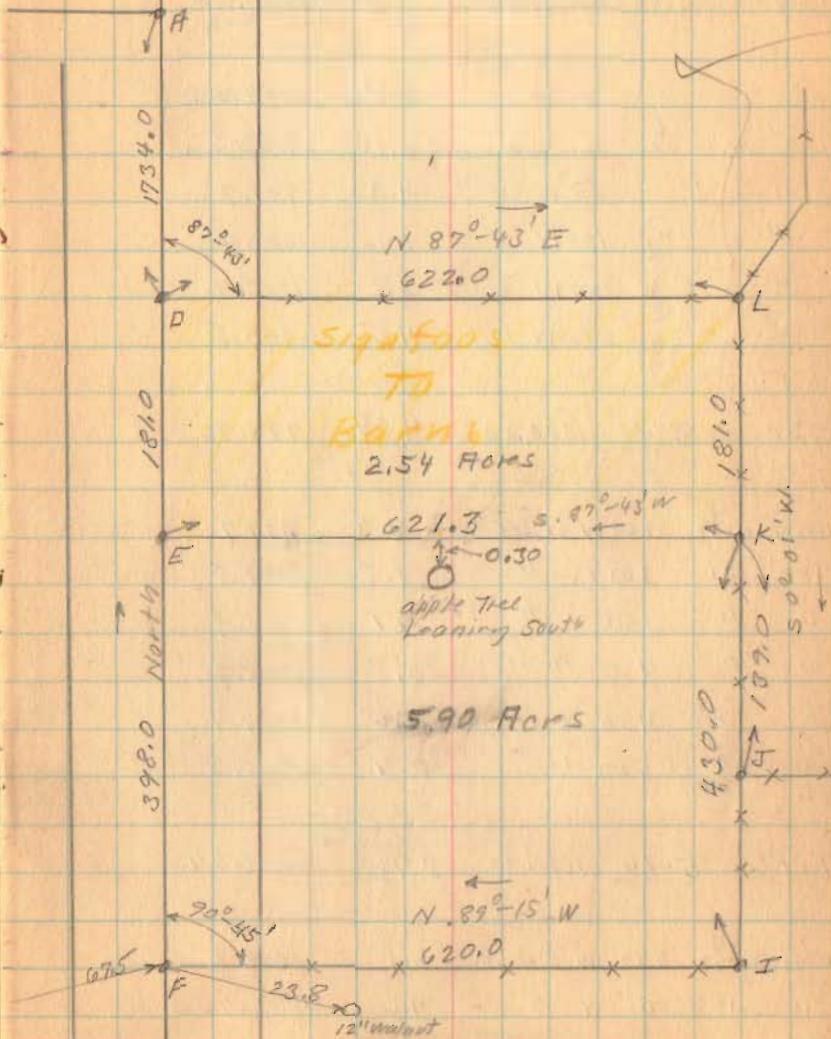

LESLIE H. GEESLIN
REGISTERED SURVEYOR NO. 5248
P. O. BOX 274
RUSHSYLVANIA, OHIO 43347

TELEPHONE: (513) 468-2793

MARTIN SURVEY

December, 1984

The following described real estate situated in the State of Ohio, County of Logan, Township of Union, being part of the northeast $\frac{1}{4}$ of Section 8, Town 3, Range 14, between the Miami Rivers Survey and more particularly described as follows:

Beginning at an iron bar in the centerline of Township Road 198 that is by deed SOUTH 1915 feet from a stone at the northwest corner of the northeast $\frac{1}{4}$ of Section 8.

Thence with the ~~north~~ ^{South} line of Billy L. Fent's 2.54 acre tract as described in D. B. Vol. 316 Pg. 631 N. $87^{\circ} 48' 25''$ E. 348.74 feet to a point.

Thence SOUTH 250.00 feet to a point.

Thence S. $87^{\circ} 48' 25''$ W. 348.74 feet to a point in the centerline of T. R. 198.

Thence with the centerline of said T. R. 198 NORTH 250.00 feet to the place of beginning.

Containing 2.00 acres and being in the northwest corner of John R. Martin's 5.89 acre tract.

The bearing of the centerline of Township Road 198 was taken from deeds. All other bearings were established from angles turned in the field.

1736 ID

REDUCED ON MAP




Leslie H. Geeslin

IRON BAR RD.

BILLY L. FENT
2.54 AC.
DB VOL. 316 1/2-631

N. $87^{\circ} 48' 25'' E.$

348.74

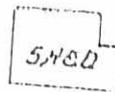

TOWNSHIP ROAD 198 (20')
NORTH 250.00'

152'

SEPTIC
TANK

SHED

WELL

1STY FRM
RES


100'

2.00 AC.

250.00'

SOUTH

348.74' 18'

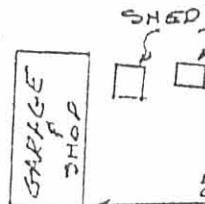

I HEREBY CERTIFY THAT
THE FOREGOING SURVEY
IS A TRUE AND CORRECT
DESCRIPTION OF THE LAND
OWNER(S) AS LISTED ON THE
MAP.

1736

IP

MADE FOR MAP

Leslie H. Geeslin
LESLIE H. GEESLIN
RUSHSYLVANIA, OHIO



SURVEY OF 2.00 AC. TRACT IN N.E. 1/4 SEC.
8, TOWN 3, RANGE 14, M.R.S., UNION TWP.,
LOGAN COUNTY, OHIO.

DATE	DEC., 1984	DRAWN BY	L.H.G.	APPROVED BY
SCALE	1" = 50'	REVIBED		

MADE FOR THE KISSEL CO.

MORTGAGE PURPOSES
ONLY

DRAWING NUMBER
MARTIN



I HEREBY CERTIFY THAT
THERE ARE NO ENCROACHMENTS
ON THE ENCLOSED
TRACT.

1936

1936 Sigafos to Barnes

VN 10/254

The following described land in N. E. Quarter of Section 8, Town 3, Range 14, of between the Miami Rivers Survey and being in Union Township, Logan County, Ohio.

Beginning at a stone at N. W. corner of N. E. Quarter of said section 8 said stone being in center of road No. 200; thence with the West side of said Quarter section and the center of road No. 200 South 1734.0 feet to an iron said iron being the beginning point of this survey at S. W. corner of A. B. Barnes 6.43 acre tract, thence with said Barnes south line N. $87^{\circ}43'$ E. 622.0 feet to a point in H. W. Ewing West line; thence with said Ewing West line S. $0^{\circ}01'$ W. 181.0 feet to an Iron; thence S. $87^{\circ}43'$ W. 621.3 feet to an iron in center of road No. 200 and in the west line of said N. E. Quarter; thence with center of road No. 200 North 181.0 feet to the place of beginning said tract containing 2.54 acres more or less and being the same tract as surveyed August, 1936 as shown in Logan County Engineer's Book No. 597, Page 61 and 62.

(1936) 2D-1

INDEXED ON MAP

Vn¹ 5.90

Sigafoos 1936

The following described land in N. E. Quarter of, section 8,
Town 5, Range 14 of between the Miami Rivers Survey and being in
Union Township, Logan County, Ohio.

Beginning at a stone in N. W. corner of N. E. Quarter of said
section 8 said stone being in the center of road No. 200; thence with
the West side of said Quarter section and the center of road No. 200
said iron being the beginning point of this survey
South 1915.0 feet to an iron; thence N. $87^{\circ}-43'$ W. 621.3 feet to an
iron in Ewing West line; thence with Ewing West line S. $0^{\circ}-01'$ W.
430.0 feet to a point at one of Fultz corners; the last described line
passing the line between Ewing and Fultz at 139.0 feet; thence with
Fultz N. line N. $89^{\circ}-15'$ W. 620.0 feet to an iron in center of road
No. 200 and in the West side of N. E. Quarter of said section 8;
thence with the center of road No. 200 North 398.0 feet to place
of beginning said tract containing 5.90 acres more or less and being
the same tract as surveyed August, 1936 as shown in Logan County
Engineers Book No. ~~500~~⁵⁹⁷, Pages 61 and 62.

(1736) 2D-2

INDEXED ON MAP

F.B. 597

Sigfoos Surrey

8-14-36

62

DLKE = 2.54 Acres

FEKI = 5.90 Acres

Present Duplicate
8.13 A.
2.54 To Barns
6.59
New Survey
8.44
2.54 To Barns
5.90

1736

2P

INDEXED ON MAP

STONG,
FO

2 Story
Frame



LESLIE H. GEESLIN
REGISTERED SURVEYOR NO. 5248
P. O. BOX 274
RUSHSYLVANIA, OHIO 43347

TELEPHONE: (513) 468-2793

MARTIN SURVEY

December, 1984

The following described real estate situated in the State of Ohio, County of Logan, Township of Union, being part of the northeast $\frac{1}{4}$ of Section 8, Town 3, Range 14, between the Miami Rivers Survey and more particularly described as follows:

Beginning at an iron bar in the centerline of Township Road 198 that is SOUTH 1915 feet from a stone at the northwest corner of the northeast $\frac{1}{4}$ of Section 8.

Thence with the south line of Billy Fent's 2.54 acre tract as described in D. B. Vol. 316 Pg. 631 N. 87° 48' 25" E. 619.72 feet to an iron bar in a west line of Don Downing's 89.32 acre tract as described in D. B. Vol. 346 Pg. 588.

Thence with said Downing's line and a west line of Bellefontaine Chiropractic Clinic, Inc.'s 79.5 acre tract as described in D. B. Vol. 400 Pg. 283 S. 00° 03' 30" W. 430.41 feet to an iron bar.

Thence with a north line of said Clinic N. 89° 11' 21" W. 618.89 feet to an iron bar in the centerline of T. R. 198.

Thence with said centerline NORTH 397.94 feet to the place of beginning.

Containing 5.89 acres more or less.

The bearing of the centerline of Township Road 198 was taken from deeds. All other bearings were established from angles turned in the field.




(1736) 3D

INDEXED ON MAP

Leslie H. Geeslin

1915' TO STONE POINT
LINE
LINE N.E. 1/4 SEC 8 - 10
DB VOL. 316 PG. 631

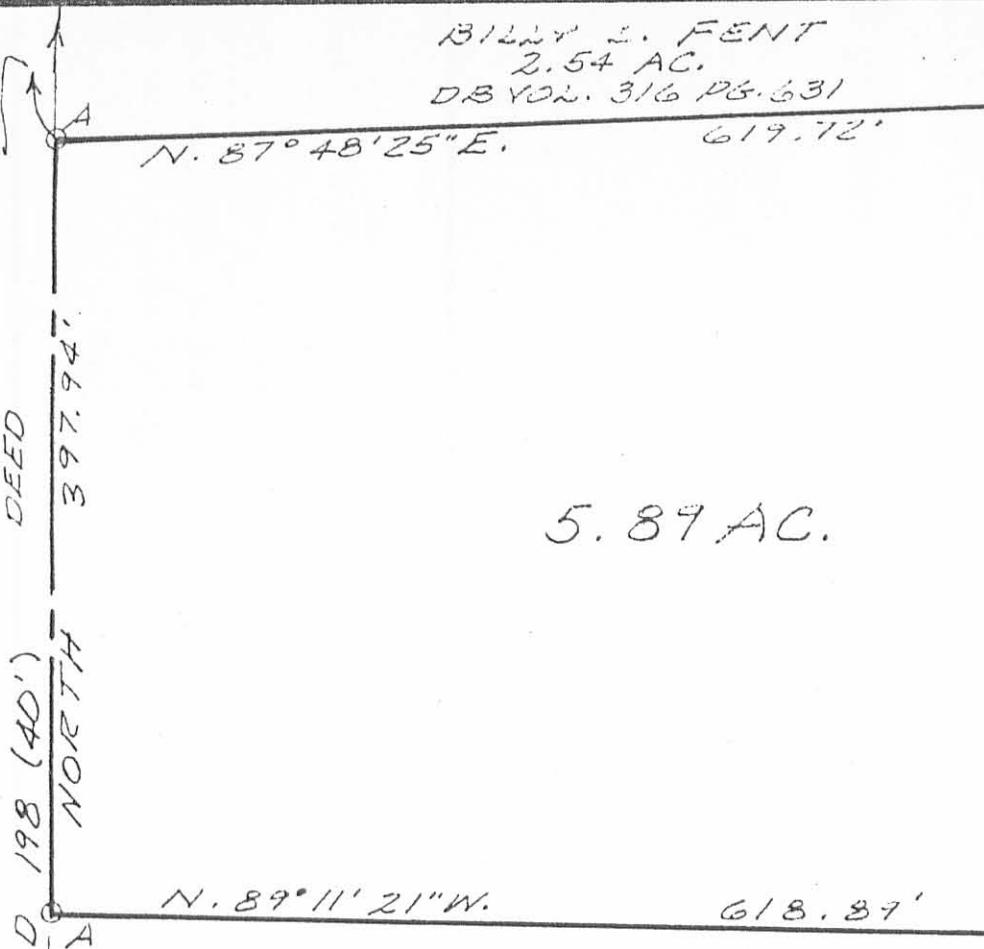

BELLEFONTAINE CHIROPRACTIC CLINIC, INC.
79.5 AC.
DB VOL 400 PG. 283

1736 BP

REGISTERED SURVEYOR



Leslie H. Gleslin
LESLIE H. GLESLIN
RUSHSYLVANIA, OHIO

SURVEY OF 5.89 AC. TRACT IN N.E. 1/4 SEC.
8, TOWN 3, RANGE 14, MRS., UNION TWP.,
LOGAN COUNTY, OHIO.

DATE DEC., 1984	DRAWN BY L.H.G.	APPROVED BY
SCALE 1" = 100'	REVISED	
		DRAWING NUMBER MARTIN