


(9)

10-12-44
Dyset
Robbins
M. Adams

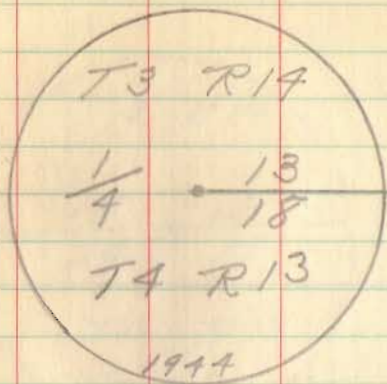


Found Stone Referred to in
 Book 558 p. 66. Flat on end: 18" Deep
 Brick under North - Small Stone on Top
 Removed Same and placed Concrete
 Marc. Full length
 Top 8" below surface of road
 Marked as above

See Book 558 page 66

32

Ed. 10 July 1972 C.N.

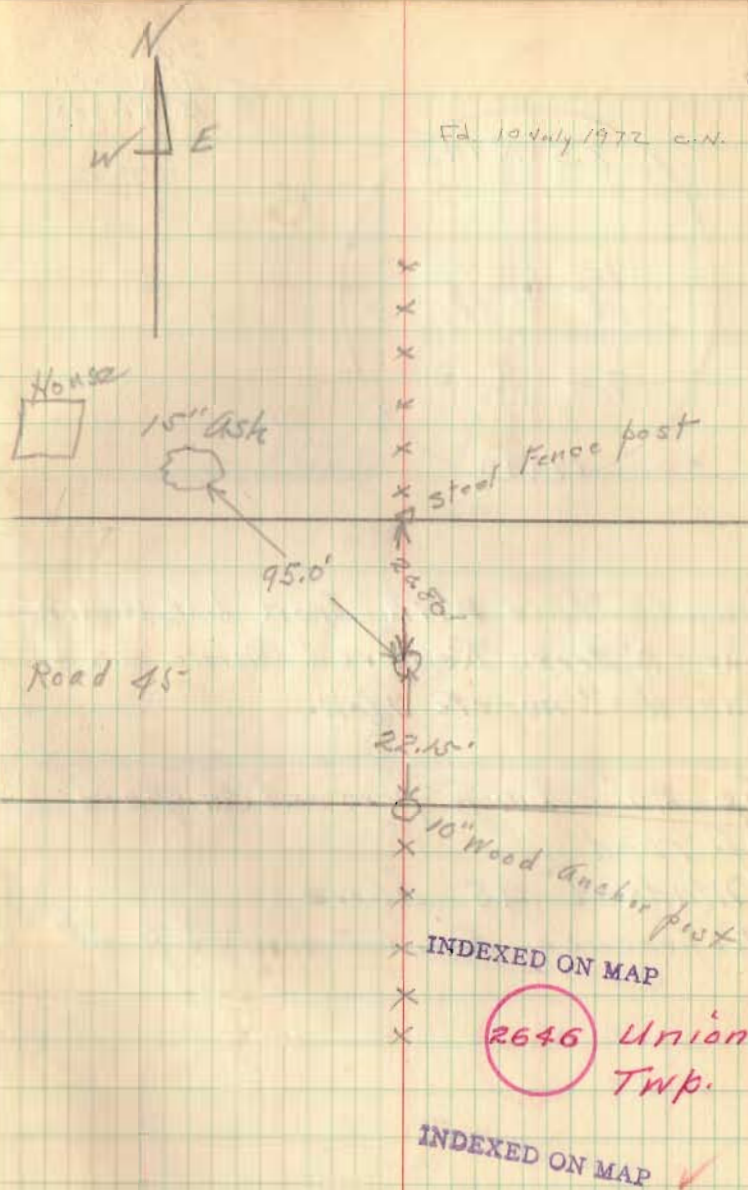

2646 Union
Twp.

INDEXED ON MAP ✓