

(22)

10-18-44
Dysoff
Robbins
H.L. Adams



Found large stone & broken bricks
See Book 575 page 38


Removed same and placed Con.
Mon. Full length - 12' Below
Road 33.

Marked as above

Ground Very soft with water
in hole.

See Book 575 page 38

45

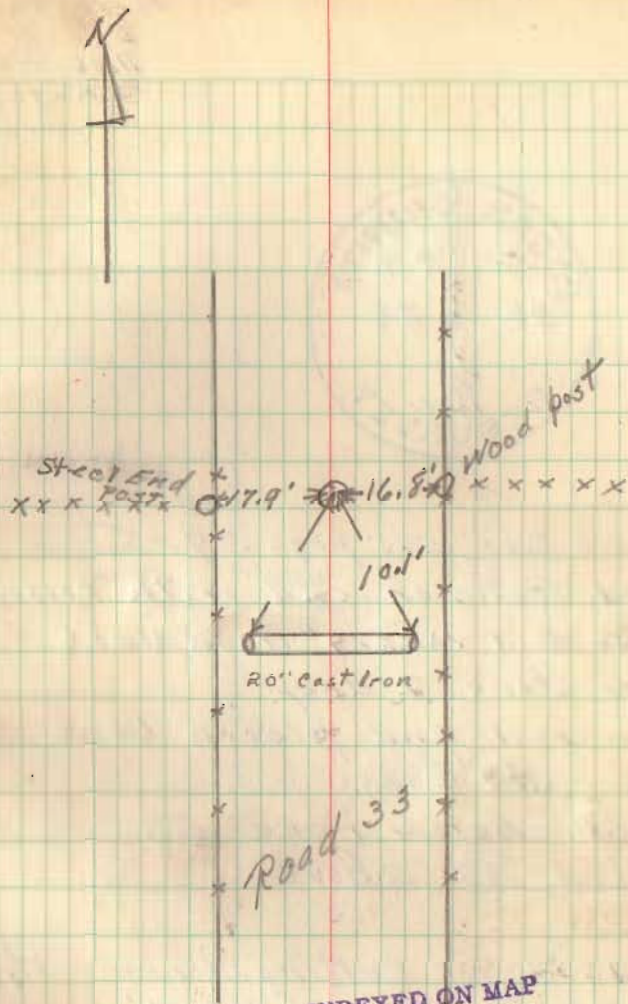

INDEXED ON MAP

Pleasant Twp.

2657 Union Twp.

INDEXED ON MAP