

FB 700

C. H. '62

Miami + Union Township

13+50.4 P.I. Also Section Corner

Note: All monument points

12+50.08 Mon. Set Set with R.R. Spike on E;

2" x 2" x 12 Wood hubs w/ nail

10+00 on R/W except where

said R/W point falls in ditch


2+00 Mon. Set 9-1-55

0+00 Mon. Set 9-1-55

Wm Lewis
P. Archer
Rivport Jr.

Union Township

Wm
9-28-54

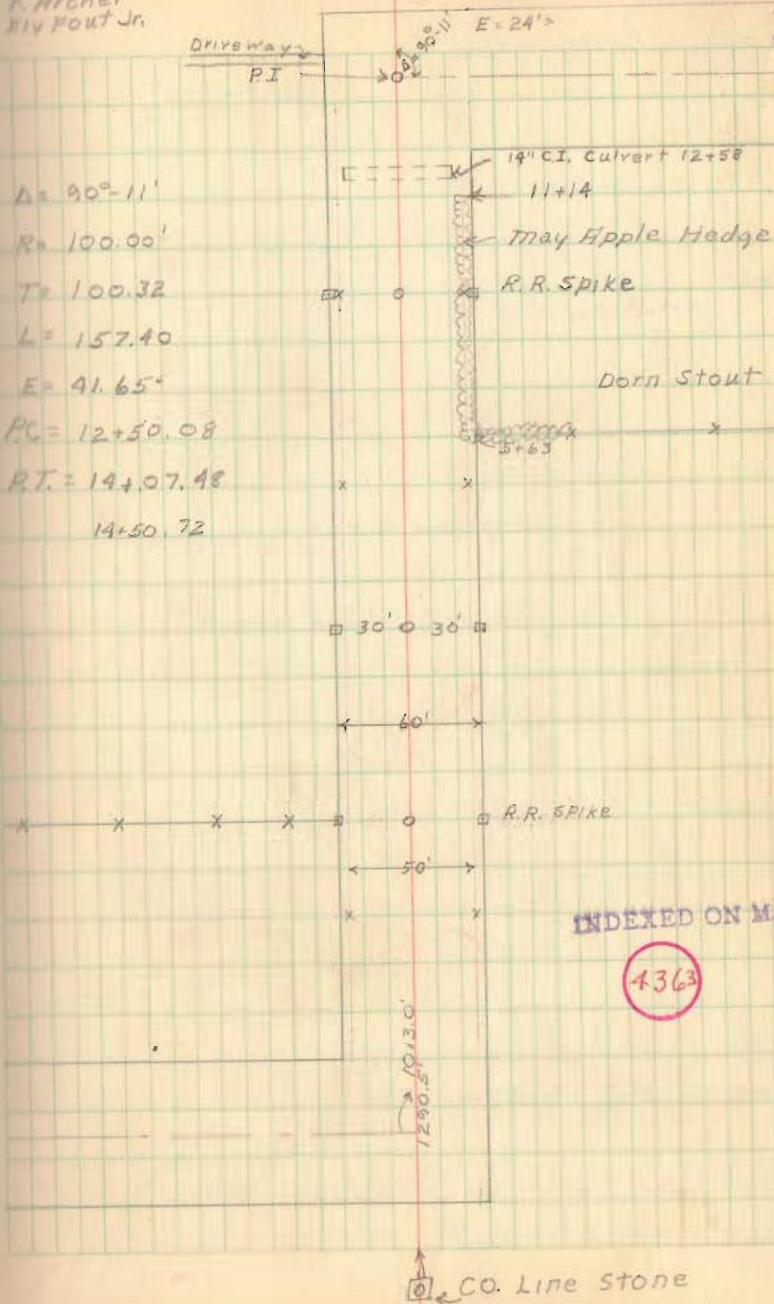

FB 700

CH#62

30+00 2 Mon. set

25+00 2 Mon. set

Driveway 21+56

Property Line Fence 21+21

20+00 2 Mon. set

15+00

14+07.48 P.I. 2 Mon. set

13+50.4 P.I. - Also Section Corner

Miami Twp.

Union Twp. 2

12" C.I. Culvert
25+67

24" Maple 27+59

Driveway

36" Maple 24+70

DRIVEWAY

24" C.I. Culvert
21+34

18" Oak
20+40

18" Oak
19+58

Twin 12" Culverts
18+10 galv.

18" Oak
16+10

1" conc. Edge Post


Logan County
Champaign County

House

Miami
Union

Barr

Note: P.I. Set with 1" Bronze Shaft

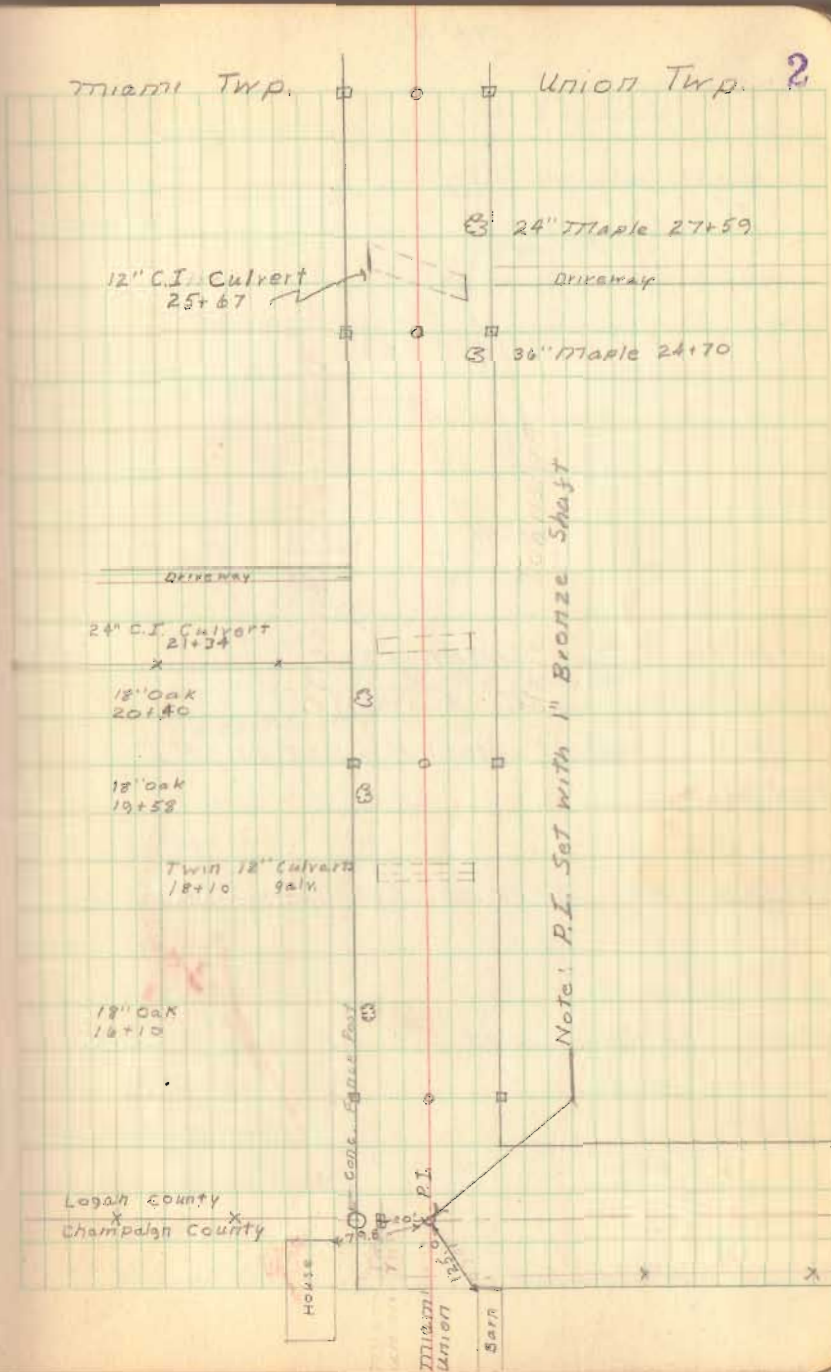

CH #62

45+00

FB 700

41+30.70 P.T.

Mon. Set.

P.I. 40+45.1



1" Steel Pin Set on P.I.

40+00

38+95.21 P.C. - 2 Mon. Set

35+00 2 Mon. Set

30+00 2 Mon. Set.

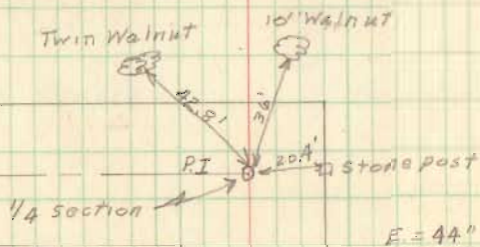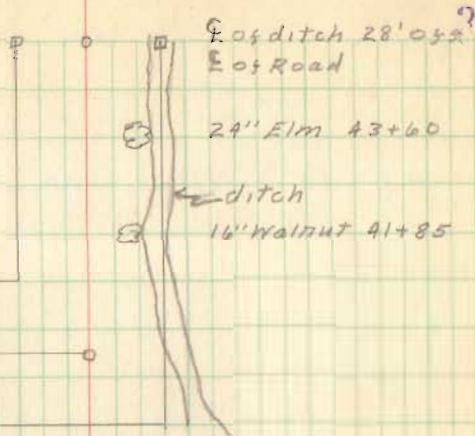

$$\Delta = 89^{\circ}57'$$

$$R = 150.00'$$

$$T = 149.89'$$

$$L = 235.49'$$

$$E = 61.98'$$

$$P.C. = 38+95.21$$

$$P.T. = 41+30.70$$

$$\text{Corr. Sta} = 41+94.99$$



16" C.I. Culvert
32x60

Miami Twp

Union Twp

FB 700

CH#62

67+09.7 P.I. Mon. Set on P.I.

66+09.7 P.C. 2 Mon. Set.


60+00 2 Mon. Set

55+00 2 Mon. Set.

50+00 One Mon. Set on Lt. Side

45+00 One Mon. Set on Lt. Side

Miami Twp

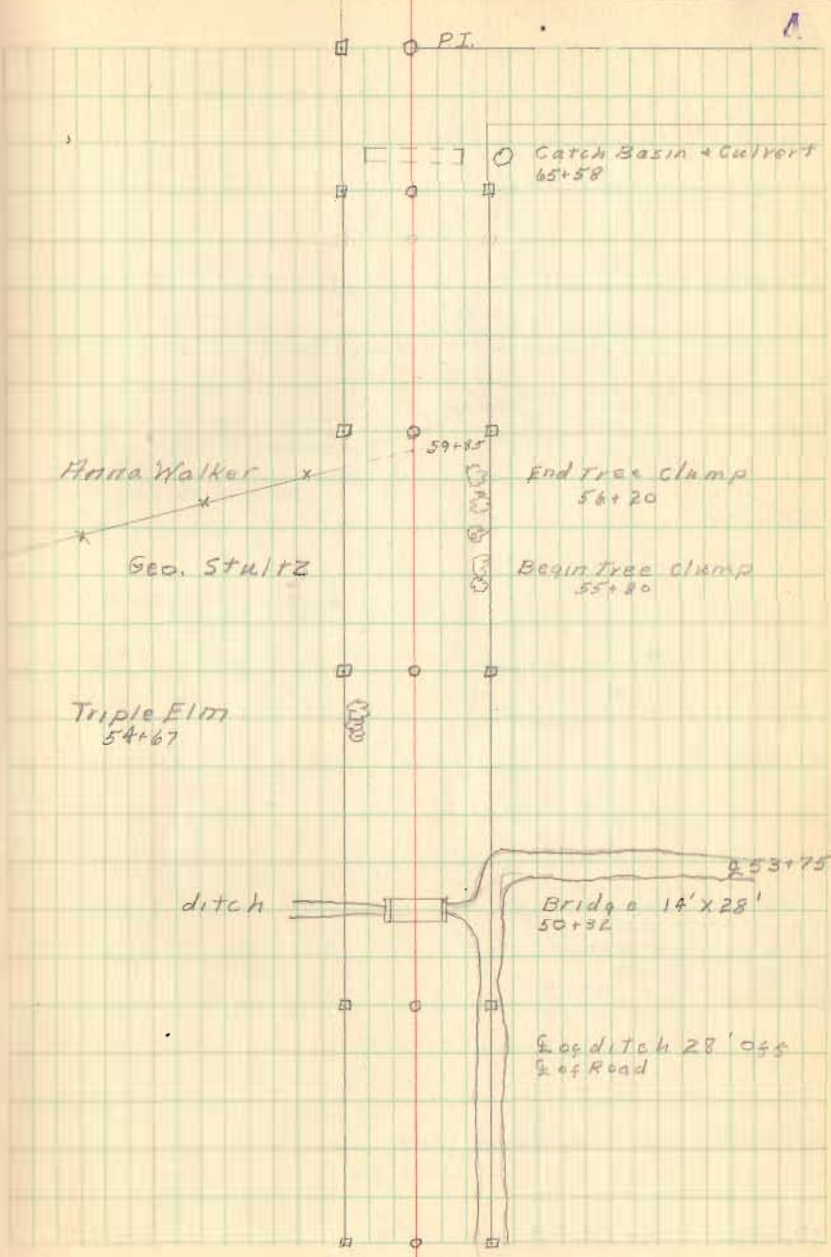

FB 700

CH #62

90+00

85+00

80+00

75+00


71+00 2 Mon. Set.

70+00

68+09.7 P.T. 2 Mon. Set.

67+09.7 Mon. Set on P.I.

31

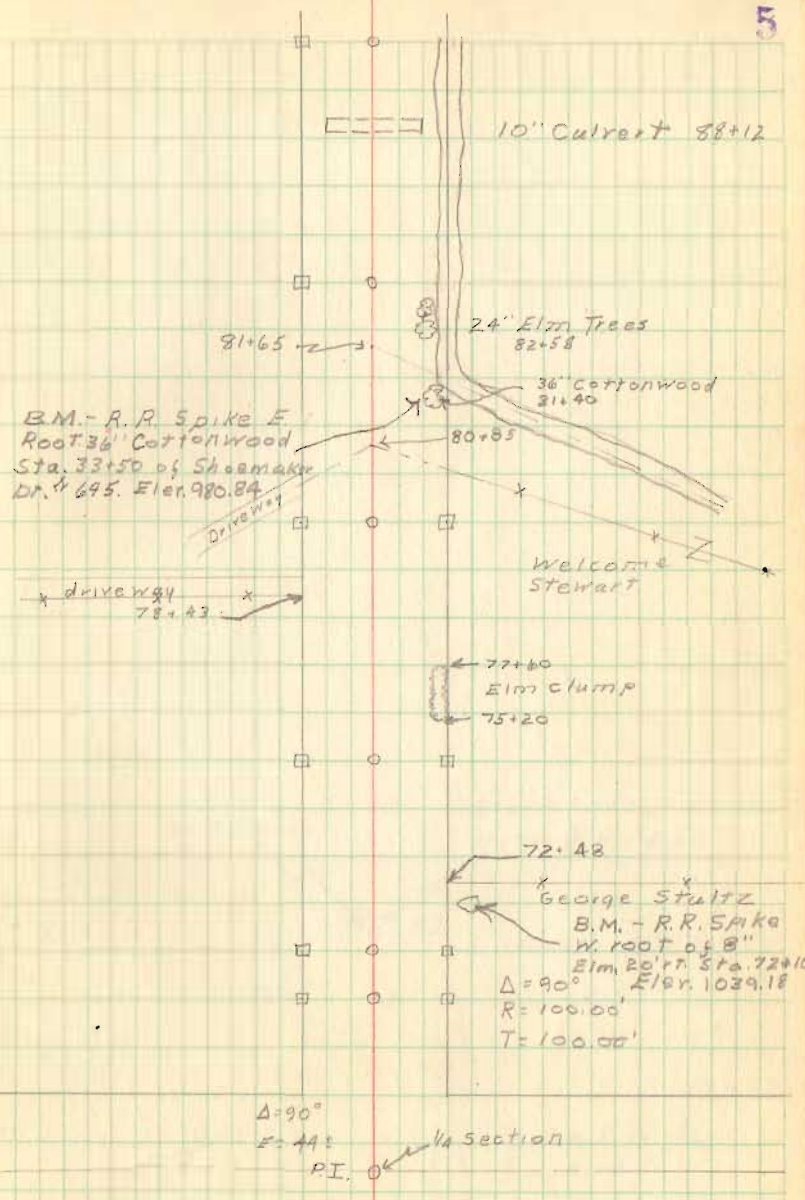

FB 700

CH #62

6

94+19.5

93+50

90+00

VA section

stone found - raised
with R.R. spike

P.I.

Route 508

Ditch 35' off
E of Road