

(154)

(154) thence between 23 & 24 & $88\frac{1}{4}$ W 320 poles, crossing a
Spring branch, to the corner of 23, 24, 29, 30 a black
Pollock } oak $\frac{7}{16}$ E. 9 links a black oak $\frac{7}{16}$ E 21 links - thence
& Clark } N 139 poles to the gr. sec. corner between sec 24 & 30
a black oak $\frac{7}{16}$ W 12 links, a black oak north 28 links
thence $68\frac{1}{4}$ E 320 poles, crossing the spring branch to the be
gaining con
- taining 28 $\frac{1}{4}$
acres -

The division line

begins at a stake
in the south line

L. Pollock	R. Clark	beginning Rock & stone
14.8 Acres	14.2 Acres	
S. N. gr. S. h. Sec. 40 & 24 R. 13		wood & dry wood

Stake

of the sec. 160 poles from each corner & runs north 144 poles to
a stake in the north line of the half sec. in the prairie -
dividing the half sec. as above marked on the plat


James Pollock } J. C.
Robert Pittman } R. C.
Samuel Macumon } S. M.

1193

Sam'l. Moore - 9th mo. 27, Sept., 1832 Survey No 193
Robt. Pittman ^{divided} Surveyed sec. 30. T. L. N. 13 M.R. for Samuel
Sue Macumon ⁸²⁷⁹ Moore, Robert Pittman, John Macumon & William
Wiley George ³ George as follows - Beginning at a stake in a prairie
the original of Secs 24 & 30 in T. L. N. thence $18\frac{1}{4}$ W with
the original line 320 poles to the corner of sec 30 & 36 a
stone in a prairie - thence 304 poles, passing the organ.
- al gr. sec. corner between sec 30 & 36 a bur oak $\frac{5}{16}$ E
29 links, a hickory

East 12 links at 16 $\frac{1}{4}$
poles) 304 poles to the
corner of Secs 29,
30, 35 & 36 original
bearing trees a hickory
 $\frac{7}{16}$ E 16 links, a white
oak $\frac{11}{16}$ W 33 links -

thence between 29 &
30 $58\frac{1}{4}$ E 320 poles
leaving the original

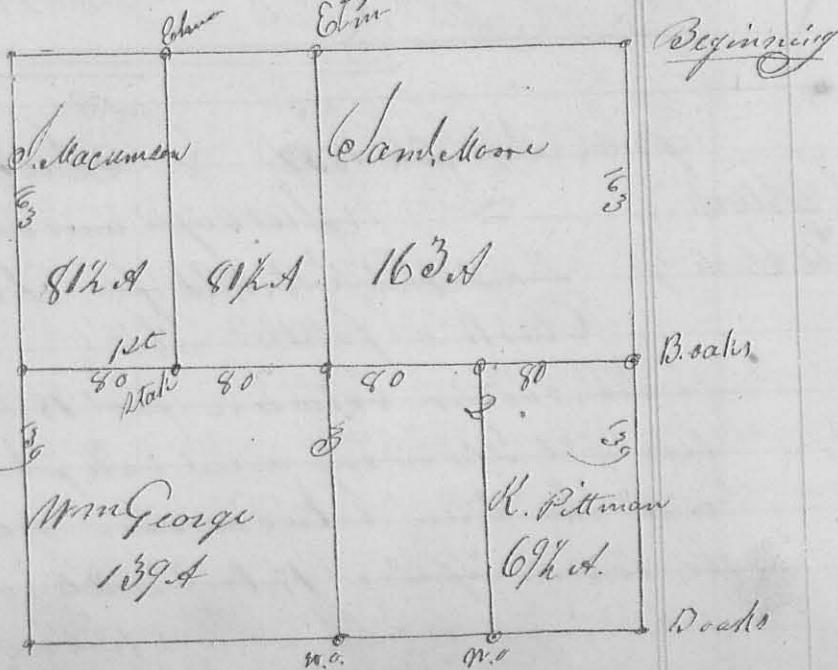

155

gr. sec. corner at 160 poles, a w. oak 470 W 8 links
 a white oak 487^o 28 links) to the corner of Sect 23, 24, 29
 & 30 a black oak 41^o E 9 links, a black oak 47^o E 21 links
 thence between Sect 24 & 30 north 304 poles (passing the
 gr. sec. corner at 139 poles) to the beginning containing
 608 acres -

1st.

The 1st division line begins at the original gr. sec.
 corner in the line between Sect 29 & 30 - thence N 89^o E at
 80 poles set a stake in a prairie, at 160 poles set a stone in
 a swamp at the centre of the sec., at 240 poles
 set a stone on a hill side, 320 poles to the gr. sec. corner
 between Sect 24 & 30 a black oak 47^o W 12 L. a black
 oak north 23 L -

2nd.

The 2nd division line begins at the stone
 on the hill 80 poles west of the gr. sec. corner last named thence
 south 139 poles to a white oak 483^o W 19 L in the south line
 of the sec.

3rd

The 3rd line begins at the original gr. sec. corner
 on the line between Sect 29 & 30 a w. oak &c - thence north
 passed the stone in the swamp & centre of the sec. at 139 poles
 304 poles to an elm in the north line of this sec 460 E
 25 links - The 4th line begins in the north line of this
 sec 80 poles east of the north west corner thereof an elm 80 W
 12 links thence 160 poles to a stake in a prairie. All of which
 may seen on the plat,

Sam'l. Moore }
 Wm Pittman } 66

D. M. Marion S. L. C.

184

annum 9th mo. (Sept, 28th 1832) Surveyor 174

8280

D. Ashen } Surveyed and divided Sect. 23. T. 4 R. 13 M.R.S.
 J. Ashen } as hereafter described for David Ashen, John Ashen
 Mr Pittman } William Pittman Robert Clark John McDonald &
 R. Clark } William New Beginning at the corner of
 Ann McDonald } Sect. 17, 18, 23 & 24 a white oak 438 W 13 links - a dog wood
 & W 26 L - thence on the line between Sect. 17 & 23
 W 342 poles to the original corner of Sect. 16, 17 & 24
 a bur oak 413 W 16 L - the other tree is down, which
 is called for here - thence between Sects 22 & 23 -

314

§ 830.74.12 13M4.R

The annexed diagram
represents the subdivision of
S30. T4. R13 N^o. 1^o made M.W.
1839 for Saint Regis & other
magnetic meridians.

L var. 30^{ft}.

Description of Camus.

A Stem in a plain.

B Snow in a field.

○ Bur Oak tree in the diameter

122W50 Lick, Walnut P15
rich diameter 818W-60 Lick

D Elm 8 inches Dr. 552 ft. 9' S. W. 1/4. Stem in a Prairie.

F. Kicken 12 in. Diametro 551250 Link. Stern.

White oak 12 ft. in. Southw. Lick, (hickory clearcut) 1760 145

H White oak 16 " 20 SSWW 8 side W Oak 20. I.D. no 7285

I White oak 20 .. N 52 W 34 + W oak 20 .. N 52 33 4

~~K~~ Stell. date 20.. " 57-E26.. Wh date 12.. " N53W40E

L. Nickay & Schmid. Nr 224 Sitt. W.O. 12 - 18810

Mr Blaak 24 detta 5698 172

Mr. Oak 15 " 38 12¹/₂

Piphoutk 15 .. 2214-23. W.O. 24 u. 5435 30

471

Surveyed Nov 2. 1850 for S. S. Hawes, Chas. Will
Barrett, Surveyor F. 950) as follows. Beginning at a
Sugar & White Oak in the West line and 5¹¹₁₂ E 109 pole from
the N W corner; thence S¹¹₁₂ E 284 poles enclosing the Kenton
Road and a branch several times to an old Bear &
Rid Oak SW corner of the Survey; thence N⁷⁸₁₂ E 602
poles to 3 Bear Oaks & Bear North side of a pond S. Elm
to said Survey; thence N¹¹₁₂ E 285 pole to a Stake; contains
part of said tract formerly owned by Matthew Birner; abt 3
Bush. thence S⁷⁸₁₂ E 402 poles to the beginning. — Then from
the center of the West line Beginning at a large old Whiskey
and Bush. 142 poles from either corner thence N⁷⁸₁₂ E 402 poles
enclosing several branches to 2 Bear Oaks N¹¹₁₂ E 115