

May 5<sup>th</sup> 1833

Surveyor 210  
Subdivision of Sec 36 T3 R14 MB


Burns  
Mefford  
Pepiyle  
Serull  
no 6 of  
Dept Survey

Stake in a prairie

Line in prairie

Stake in a prairie

Stake in a prairie

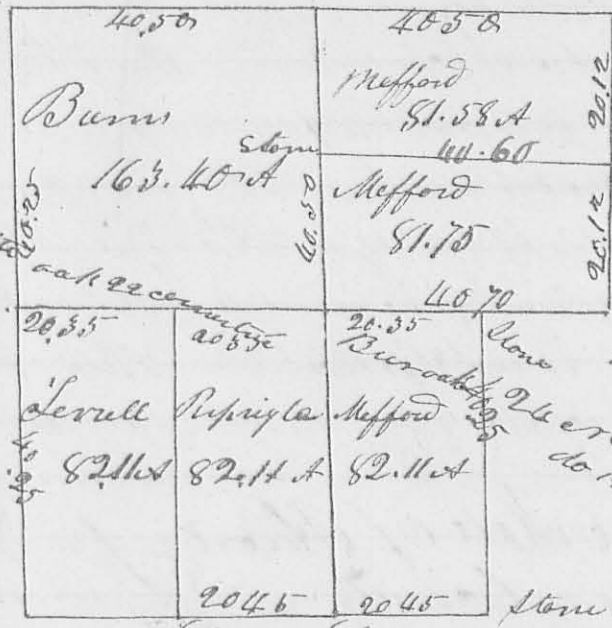

NO. 15 20 130 11 23 1/2  
do 15 1/2 565 6 47 1/2

Hickory 65 72 11 17 1/2  
Bur oak 185 266 255  
Bur oak 85 607 29  
Hickory 55 548 20

Stake in a prairie

Bur oak 24 65 7 18 1/2  
do 12 578 6 18 1/2

Shoemaker  
Daw. Jones  
1 May 5<sup>th</sup> 1833

D Hopkins Depty Surveyor

I do certify the above to be a correct copy of Surveyor no 6 returned to my office by D Hopkins Depty Surveyor L.C. Cla Wethermon 65 L.C.

6<sup>th</sup> of June 28<sup>th</sup> 1833 Surveyor 211

V. Gray  
no 211

I ran the line between Sec 147 T3 R. 14 MB. the adverse party having previous notice thereof for Vincent Gray and took the depositions which follow on the grounds - Beginning at a stake in a prairie, which stake is the one referred to by Abram Noddy in his depositions no 1. thence N 1/2 E at 90 poles took the depositions of George L Dumb no 2 John Haller 3 and Abram Noddy no 40 it being on the south bank of a small lake or canal to the water

171 in the lake at 104 poles, it is 20 poles wide at 160 of 171  
poles took the deposition of John Hall at 5' end of G &  
Dunn & Co. and here I caused a stone to be planted  
which bears N 86° E 6 poles and 3 links from a spring at  
the base of the hill, present John Hall & Snoddy Geo &  
Dunn, Rachel Blaylock, Samuel Carter, & chain men,  
continued same course, passed an old lime tree at 272 poles  
322 poles to the line between the 1<sup>st</sup> & 2<sup>nd</sup> tier of sec in this  
township, planted a stone, from which a white oak  
bears N 45° E 54 links -

Isaac Powell }  
Abraham Coffey } Co. James McManis } S L C

Depositions taken on the ground when  
making the foregoing survey -

The State of Ohio }  
Logan County }  
June 28<sup>th</sup> 1833

The deposition of Abner Snoddy taken relative to  
the distance of a stake at the intersection of the line  
running east and west & north and south at the  
corner of sections 6 & 12 T 4 R 13 & 1 & 7 S 3 R 14 M B  
which was taken the 28<sup>th</sup> day of June A D 1833, the  
adverse party having previous notice, who being duly  
sworn deponent and saith "That in the summer of  
1830 (the deponent) in company with John Dunn &  
John Foster searched for said corner, and found an  
old stake in the following manner (to wit, by placing  
one of their party in the prairie, while the other  
two took the range of the lines, and gave directions  
to the one in the prairie to stand at the point of  
intersection, but that before they had fully accom-  
plished their directions, by taking the range of the  
lines, the one in the prairie cried out to them  
that he had found the stake, and that he the de-  
ponent has ever since been acquainted with  
the place and really believes that the old stump of

172 a stake now remaining in this prairie is at <sup>172</sup>  
the same place, it having been recognized by the neigh-  
-bor over since as a section corner" and further this de-  
-ponent saith not here Sworn to and subscribed  
on the ground before me by said Honer Snoddy  
the date above written J. McKinnon C.S.L.C.

N<sup>o</sup> 2

The deposition of George H. Dunn  
taken on the line between Sec 147 Town  
N<sup>o</sup> 3 R. N<sup>o</sup> 16 at 90 poles from the south corner  
of said Sec. who being duly sworn deponent  
and saith

That he has known that there was a line marked here  
on some of the trees in this grove, and that he has re-  
peatedly seen said line, and that he has seen one or  
more line trees between this point and the corner marked  
a line from more than twenty years ago, and frequently  
since that period until the trees were cut down"  
and further this deponent saith not G. H. Dunn  
Sworn to and subscribed on the ground before me this  
28<sup>th</sup> of June A.D. 1833 J. McKinnon C.S.L.C.

N<sup>o</sup> 3

The deposition of John Hall taken on the line  
aforesaid, who being duly sworn deponent  
and saith— That he traced this line from  
the corner south, to this ~~place~~ 24 years ago, and that  
there were three trees marked between the corner and the  
lake, and that they were at or near the place which  
I have just now removed! and further this deponent  
saith not John Hall

Sworn to and subscribed before me on the  
ground this 28<sup>th</sup> day of June A.D. 1833 J. McKinnon  
C.S.L.C.

N<sup>o</sup> 4

The deposition of Honer Snoddy taken  
on the line between Sec 147 T. N. 14 R. 14 at  
90 poles from who being duly sworn deponent and saith



173  
173  
a That for a period of 23 years he has known  
that there was a line on this bank marked as a  
line between said Sec. & that said tree formerly  
stood near the line which the Surveyor has just  
now run." — At 156 poles he further saith that  
he knows that there were trees marked on this  
bank near this place, which were considered by  
himself and others as a continuation of said sec  
line" and further the deponent saith not —

Abner Snoddy,

Sworn and subscribed on the ground before me  
this 28 of June A.D. 1833 J. W. Harmon, C. S. & L. C.

No 5

The deposition of John Hall  
taken on the aforesaid line at 160 poles  
who being duly sworn deposes & saith

"That 18 or 20 years ago he was here, and at this point  
there stood 2 trees marked as a gr. sec. corner trees  
usually are —

Questioned by Surveyor

What kind of timber were these trees?

Ans<sup>r</sup> of the deponent — They were white oak

Q. by Surveyor — What was the size of these trees?

Ans<sup>r</sup> — They were about 15 inches in diameter

Q. by the Surveyor. How were these trees marked?

Ans<sup>r</sup> — They were blazed about 7 inches long about  
three feet from the ground, and a small notch  
cut into this blaze —

Q. by Surveyor. On which side were these trees marked?

A. — The tree that stood most easterly was marked  
the westerly side, and the one most westerly was  
marked on the northerly side"

Q. by Surveyor — Are thou sure that the roots which I caused  
to be dug up to day were at the place where one  
of said trees stood —

Ans<sup>r</sup> — I believe that it is the place, and further this deponent  
saith not


John Hall

174 Sworn to and subscribed on the ground before me  
the 28<sup>th</sup> day of June A<sup>d</sup> 1834 James Williamson  
C. S. L. C.

N<sup>o</sup> 16 The deposition of George F. Dunn taken on  
the aforesaid line at 160 poles it being on a  
bank north of a small lake, who being duly  
sworn deposes and saith "That about 20 years  
ago he was first acquainted with this place, that there  
were then, and for several years since trees some where  
near this point marked as quarter section corners  
and believes the place when the roots were dug out and  
referred to in John Walls' deposition were at the place  
when one of said trees stood" — And further this depo-  
nent saith not. G. F. Dunn

Sworn to and subscribed before me on the ground  
the 28<sup>th</sup> day of June A<sup>d</sup> 1833 J. Williamson  
C. S. L. C.

I James Williamson County Surveyor of Logan  
County do hereby certify that the foregoing are  
true copies from the original as taken on the ground  
and place on file in my office June 28<sup>th</sup> 1833  
James Williamson  
C. S. L. C.

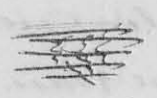

(8197)  
P. H. Intine & Winters  
No 212  
11<sup>th</sup> mo 1833  
Surveyed the S. W. q. and E. 1/2 of S. E. q. of  
Sec. 9 T. 1 R. 8 E. of Meridian for Patrick McIntire  
and Owen Winters. Beginning at the southwest  
corner of said sec. original bearing trees standing a "beech S 52 E  
27 L. a beech N 27 W 5 L. thence between sec. 9 & 16 N 86 E  
240 poles a beech South 7 L. thence N 4 W 160 poles (crossing  
the road from Bellefontaine to Chidney) to a beech east  
29 L. thence S 86 W 240 poles a bur oak S 58 E 12 L. a  
beech N 71 E 13 1/2 L in the west line of the sec. — thence with  
said line S 4 E 160 poles (crossing said road) to the beginning