

11/12/12 Parmer Survey North of Lewistown Sec 13, T. 7 R. 8 Washington

48. N. Line S 89° E 650.9' (986)
 BC Road S 10° E 152.1' (230)
 CD Road S 24° W 892.2 (13520)
 DE Along fence N 10° E 523.2 (7930)
 EF along fence N 89° W 239.3 (3630)
 FA along R.R. N 10° W 449.5' (6810)

Bearings
 From
 Needle

AB = S 89° 03' E.

BC = S 10° E

CD = S 25° 05' W

DE = N 10° 18' E.

EF = N 89° 20' W

FA = N 90° W.

Bearings from
 angles!


46

INDEXED ON MAP

Course	N.	S	E	W	DMD.	N.	S
AB		.16	9.85		9.85		1.567
BC		2.27	.40		20.10		45.627
CD		12.25		5.73	14.77		180.933
DE	7.92		.18		9.22	73.022	
EF	.04			3.63	5.77	.211	
FA	6.72			1.07	1.07	73.90	
	14.68	14.68	10.43	10.43		806.43	228.136

1:2002

10/605.843
 2/147.49
 7374

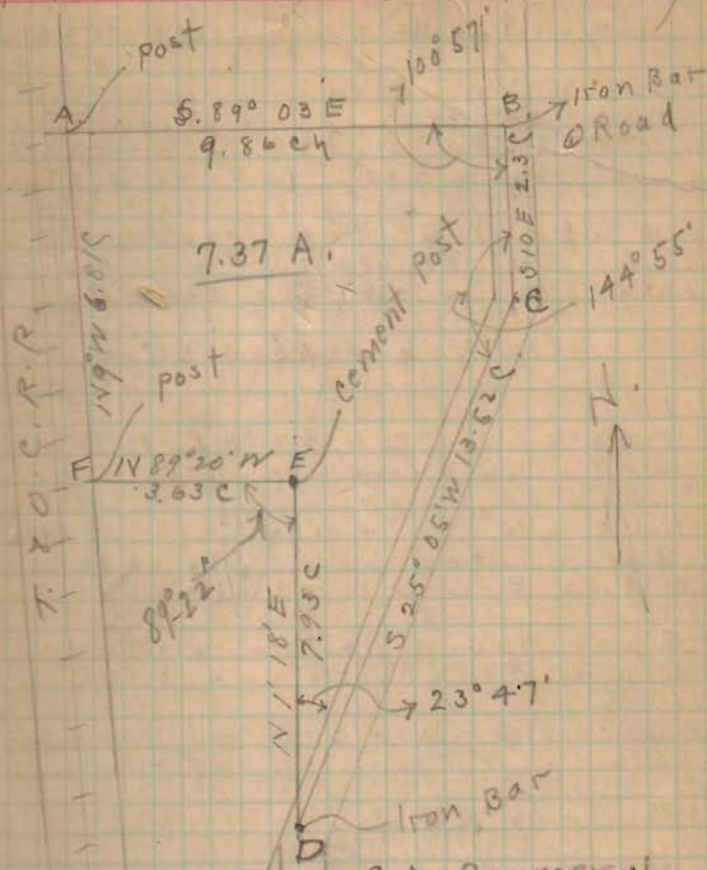

S. A. Parmer ch
 Parmer ch
 Parmer Flag