

Road 211
Pleasant & Washington TWPs.

32' Road Road Record Vol. 3 PP 214-229

Map - Road Record Vol. 3 - Page - 222

1901.

staked, 32'


sta. 22-24-26-28-30 etc.

1657

INDEXED ON MAP


May-14-1935
cloudy-cool
E. Wright
E. Co. Ave.
Wagner

Joseph Kaylor

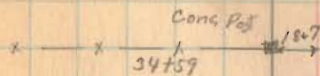


J. W. Bartleson

Howard S. Kaylor

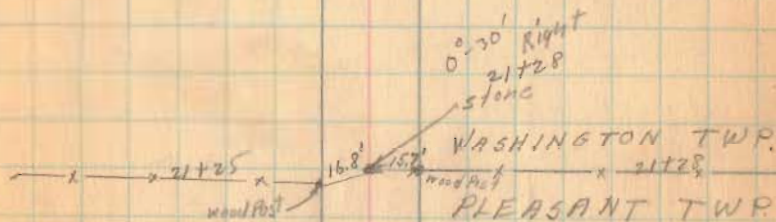

Phoebe A. Martin


Bellefontaine Bldg.
& Loan Co.

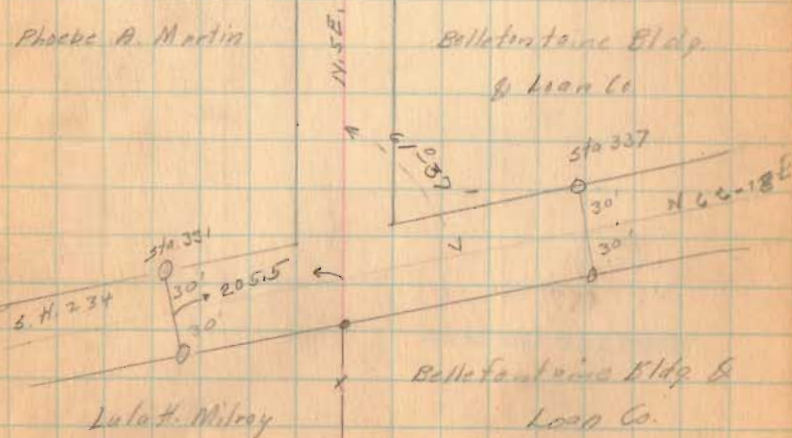

Road 211


5-14-35

48

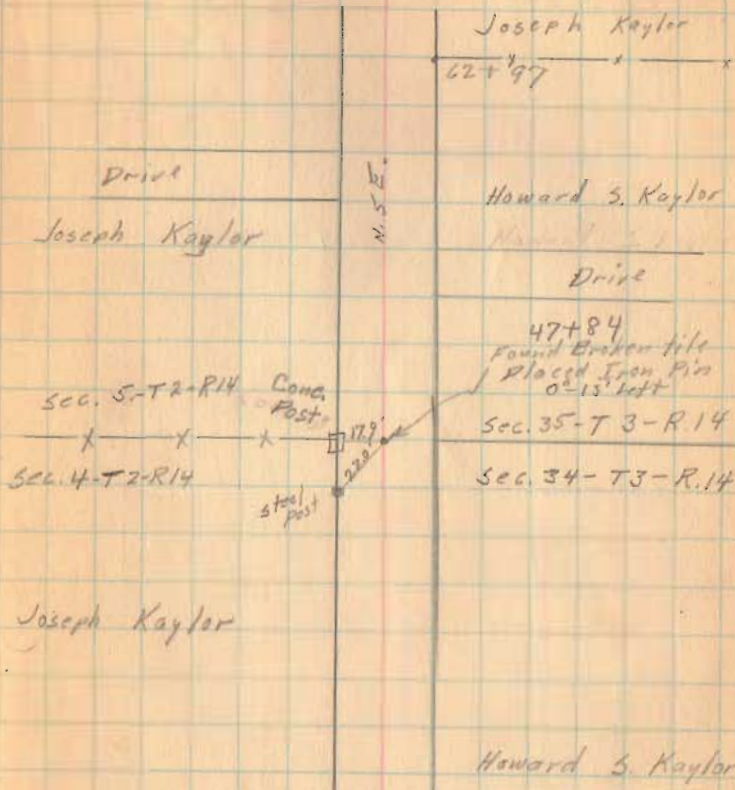

1657

INDEXED ON MAP

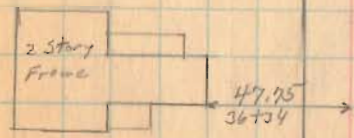

Road 211

Road 207

1657

INDEXED ON MAP

5-14-25

29

