

June-5-1937  
 Wm  
 F. Wright.  
 W. B. Wright


40

Lot 119  
 Mountwood.  
 Washington Twp.

See J-9  
 See Plat Book 3-C Page 9

- A Found old Hub Placed 2"x2"x24" Hub
- B " " " " "
- C " " " " "
- D " " " " "
- E " " " " "
- F " " " " "
- G " " " " "
- H " " " " "
- I Placed Iron Pipe
- J Found old Hub Placed Pipe
- K " " " " "
- L " " " " "
- M. I. Pipe Found

For Conrad Flockencier  
 101 N. Elm Bellefontaine

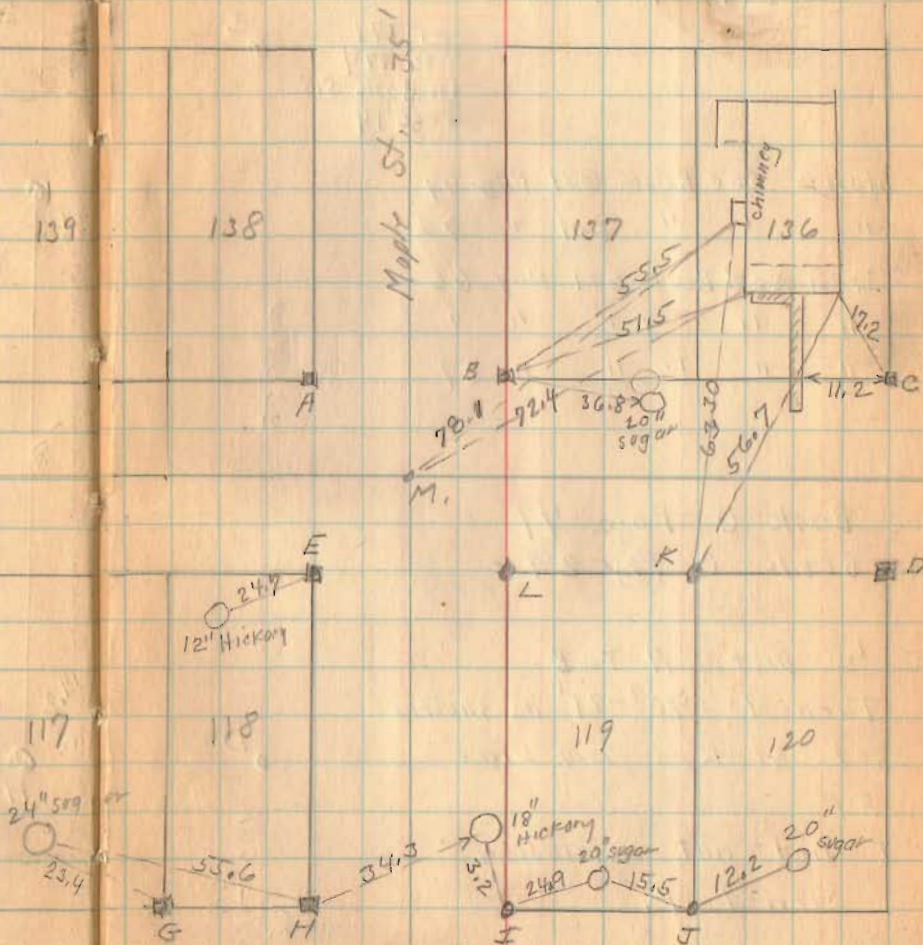

1782

INDEXED ON