


Marion Drive - 5 Parks Allot.

map A

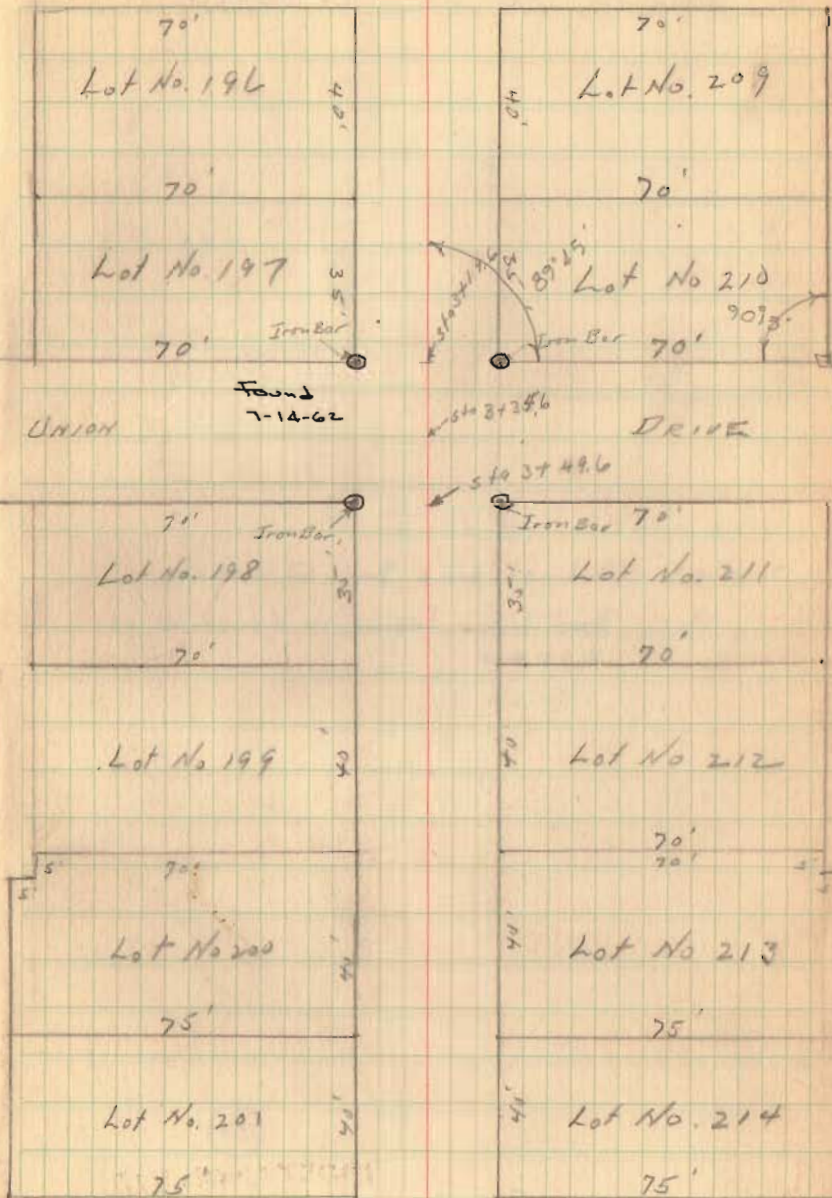

1826

INDEXED ON MAP

Marion Drive 5 Parks

7-14-62 - Did not find Bars @ G+04.6
Bar found laying in fence w. of
G+04.6

1826

INDEXED ON MAP

75

