



Montgomery Drive - Five Parks Allotment


Nov. 8, 1940  
 Elora  
 Gwilfus  
 & Jones. 77

1827

INDEXED ON MAP

UNION


DRIVE

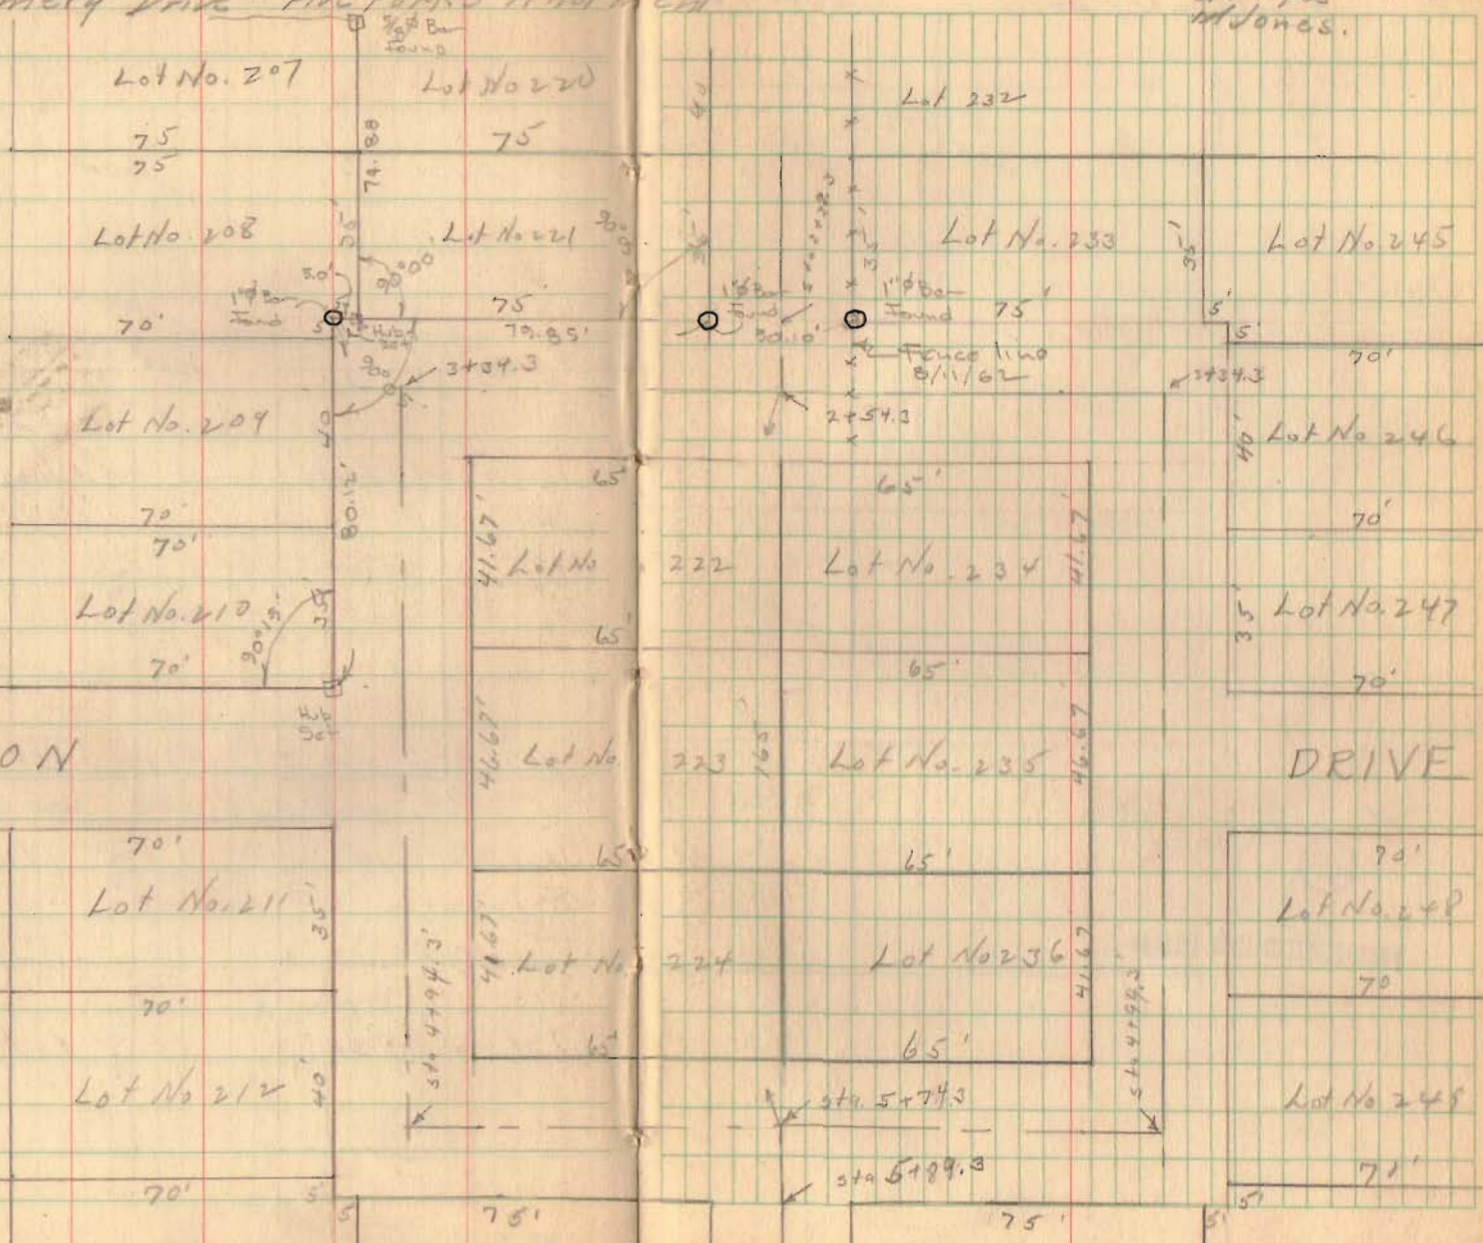

Montgomery Drive

Five Parks Allotment

75

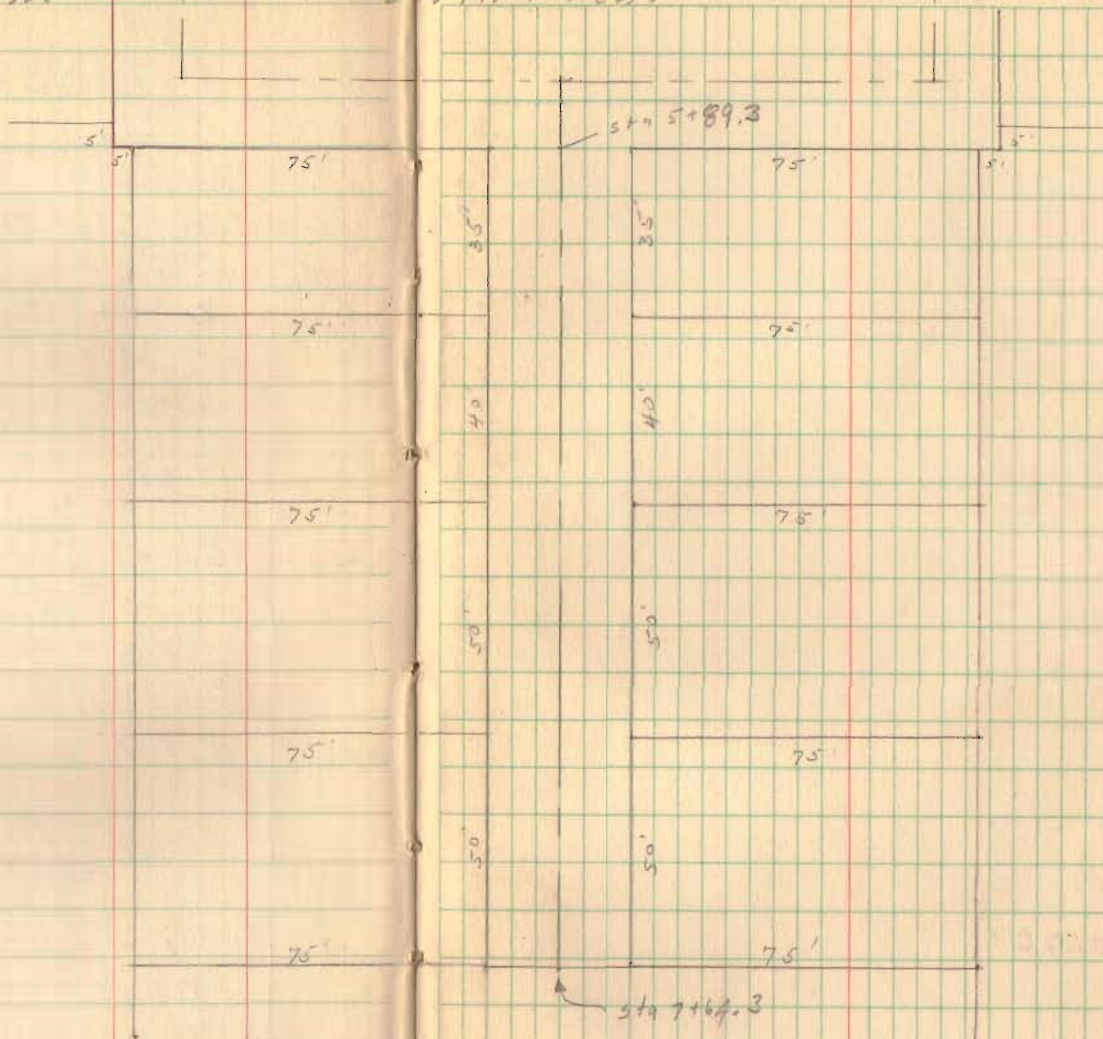

1827

INDEXED ON MAP