

UNION DR. - FIVE PARKS

Washington twp.

Union Drive - 30' wide

Surveyed by order of Washington twp. trustees.

Surveyed by D. T. Dodson Mar 18, 1954  
 V. T. Detrick & Nice day 50°  
 T. T. Richardson-ch.


See pg. 9 for continuation

Note -

Streets originally 25.0' wide -  
 5.0' strip taken off N. side of  
 lots "45" to "62" makes Union Dr.  
 30.0' wide -

5.0' strip off E. side of lots  
 "44" to "35" makes Hardin Dr.  
 30.0' wide

5.0' strip off W. side of lots  
 "42" to "32" makes Allen Dr. 30'

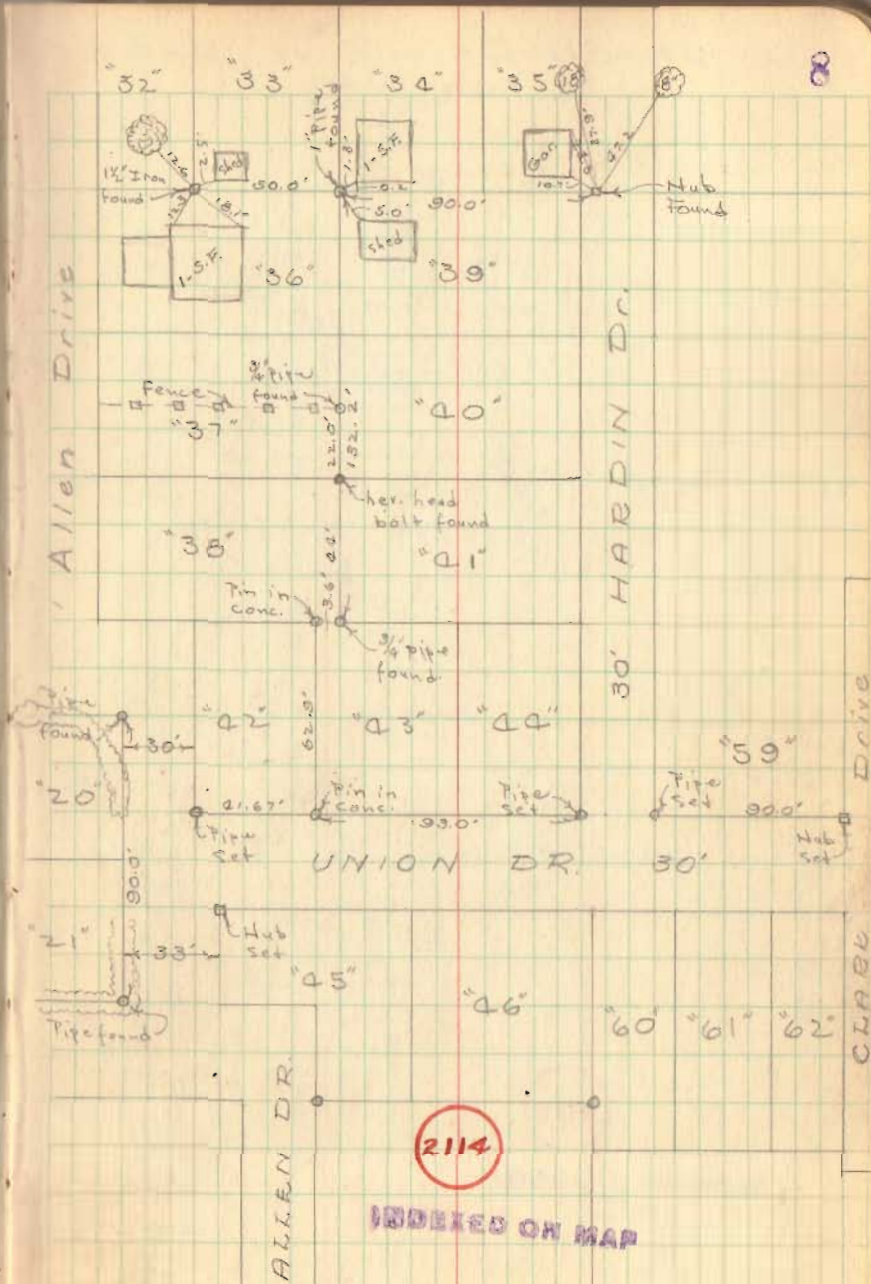


FB 699

UNION DR - FIVE PARKS  
cont'd

Mar. 18, 1954

50°

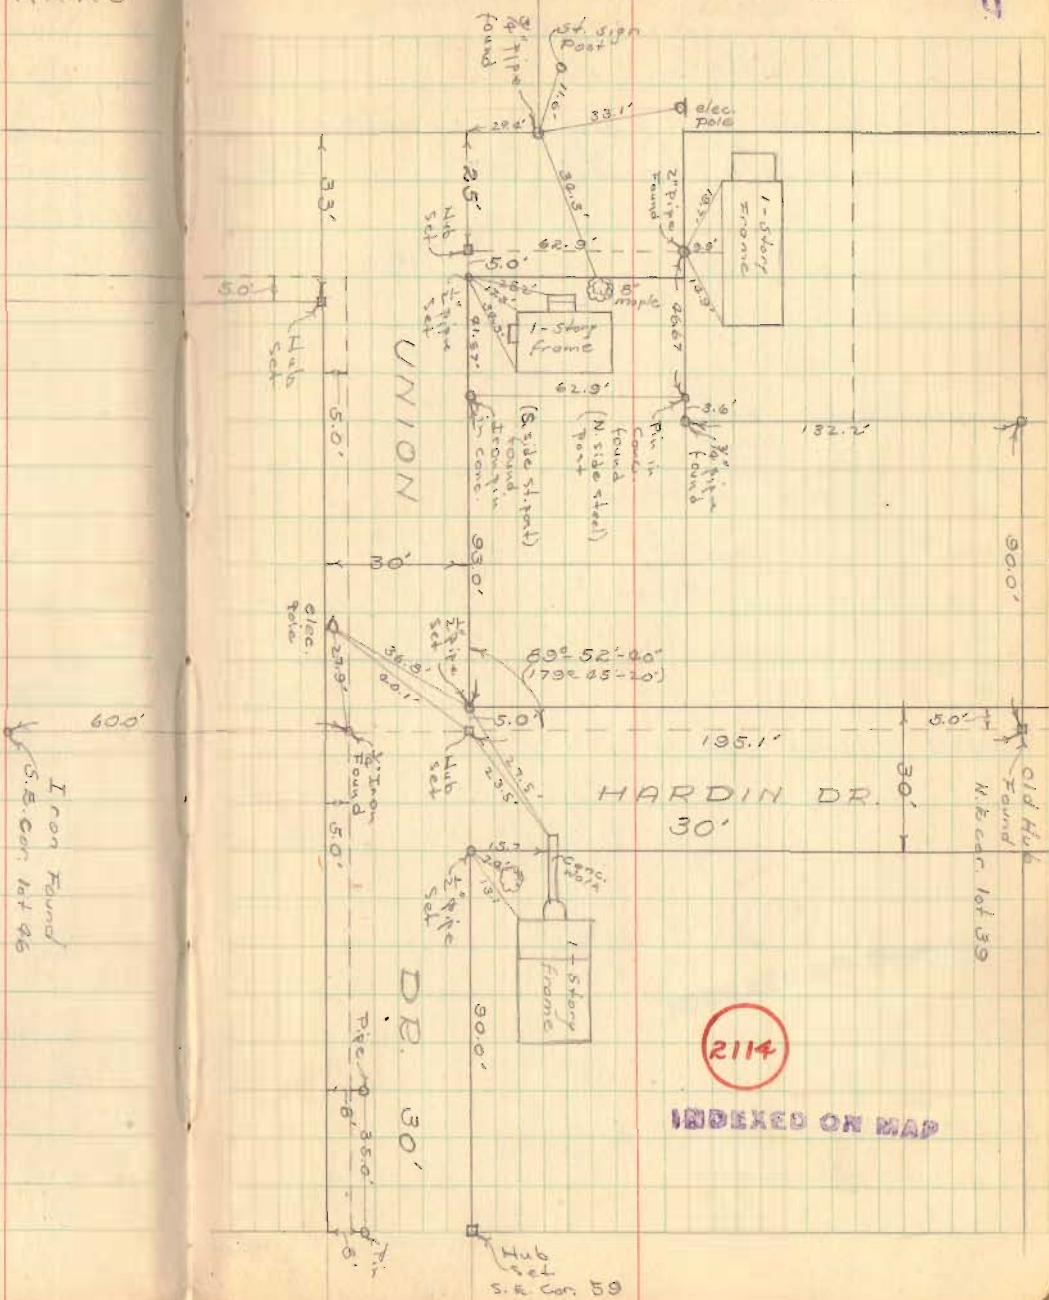

2114

INDEXED ON MAP

111