

109


Survey of Lots 69-70

Fire Parks Allotment.

Washington Trwp. Logan Co Ohio
for John Ziegler R.D. Monteville O.

- A iron bar (found) SW cor Lot 51
- B 5/8" pipe (found) SW cor Lot 80 (found)
- C old stake (found) SW cor Lot 71
- D 3" concrete m (found) NW cor Lot 95
- E 3" concrete m (found) NE cor Lot 95
- F 3" concrete m (found) SE cor Lot 95
- G pipe (set) on line AB 85.0' from A
- H stake (set) 40' from G on line GC
- I pipe (set) 80' from G on line GC
- J pipe (set) on line ID 85.0' from I
- K stake (set) on line JI 40' from J
- L pipe (set) on line AB 70' from A.

Chas. Inskeep
Carpenter
EL. Monteville
12-3-46
Cold
110
→ To Bellefontaine
JH 168 SE 32

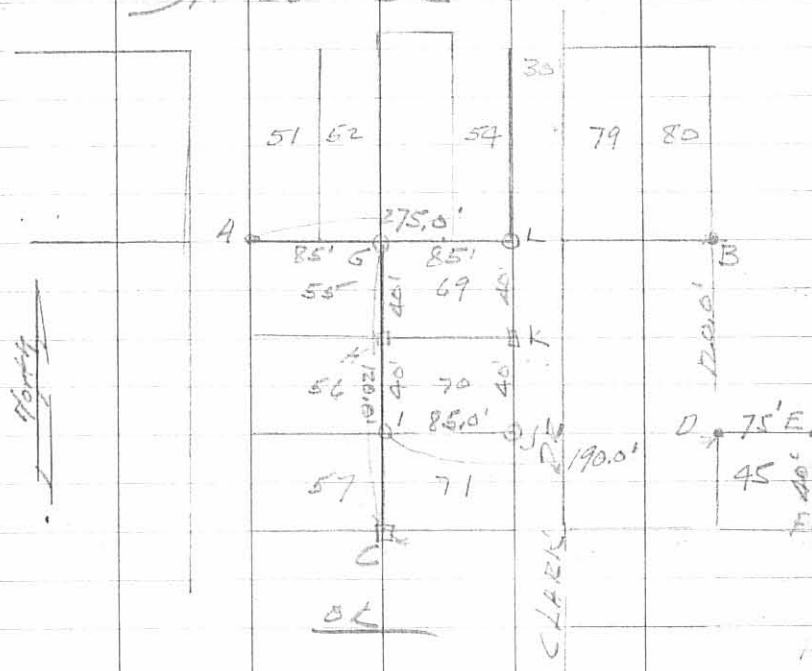

INDEXED ON MAP

2342 1P



SURVEY OF
LOT 71

FIVE PARKS ALLOTMENT
WASHINGTON TOWNSHIP
LOGAN COUNTY, OHIO
SCALE 1" = 20'
JULY 29, 1980

INDEXED ON MAP
2342 ZP

DAN L. DODSON
REG. SURVEYOR 4270
BELLERON TAINE, O


Survey of Lots 69-70 Fire Parks Allotment.

Washington Trwp, Logan Co. Ohio
for John Ziegler R.D. Monteville O.

- A iron bar (found) SW cor Lot 51
- B 5/8" pipe (found) SW cor lot 70 (Record)
- C old stake (found) SW cor Lot 71
- D 3" concrete M (found) NW cor Lot 95
- E 3" concrete M (found) NE cor Lot 95
- F 3" concrete M (found) SE cor Lot 95
- G pipe (set) on line AB 85' from A
- H stake (set) 40' from G on line GC
- I pipe (set) 80' from G on line GC
- J pipe (set) on line ID 85.0' from I
- K stake (set) on line JI 40' from J
- L pipe (set) on line AB 70' from A.

CA/Askeep 110
Campbell 12-3-46
FL Horrell Cold

→ TO Bellefontaine
5H 16.8 3E 33

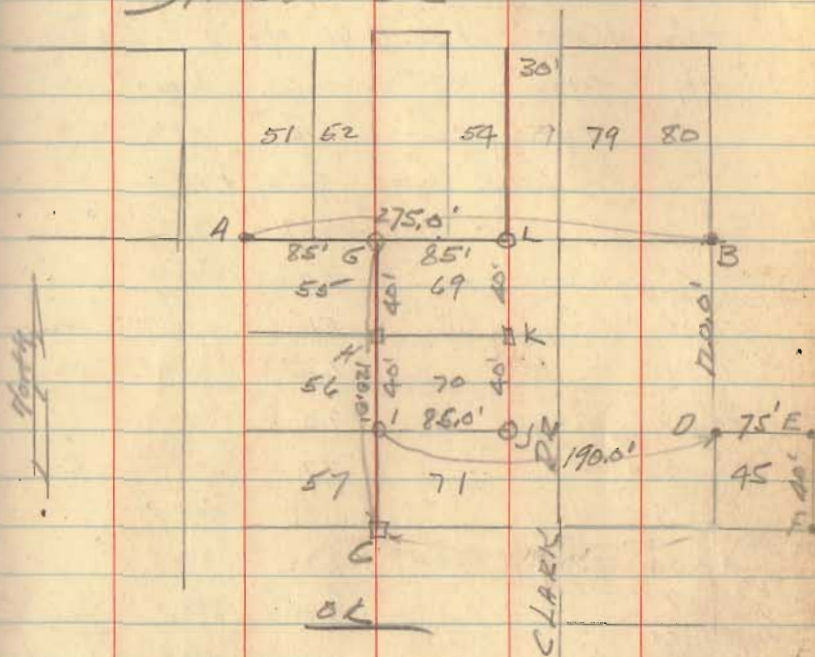

INDEXED ON MAP

2342