


Nealey Island

FB State Book 1

3

A iron at end of
SR 708 - Sec Co. Engr ~~SR~~
F.B. 590, pg 19

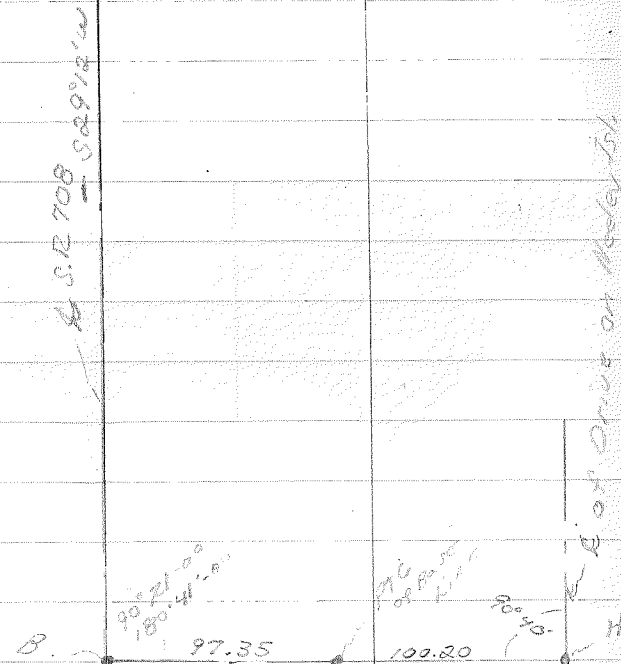


INDEXED ON MAP
3956

BASIC TRAVERSE HEELEY

Pt.	Dist.	Defl.	Cal. Bear.
L		4°-14L	
	207.14		S 31-40W
K		2-23RT	
	146.39		S 29 17 W
J		92-16 RT	
	85.00		S 62-59E
G		5-34 RT	
	69.93		S 68-33E
F		25-33 RT	
	30.00		N 85-54 E
E		58-18 RT	
	70.15		N 27-36E
D		12-24 LT	
	35.93		N 40-00E
C		79-33 LT	
	97.35		S 60-27E
B		89-39LT	
	622.64		S 29-12 W
A			

INDEXED ON MAP
3956

FB State Book 1

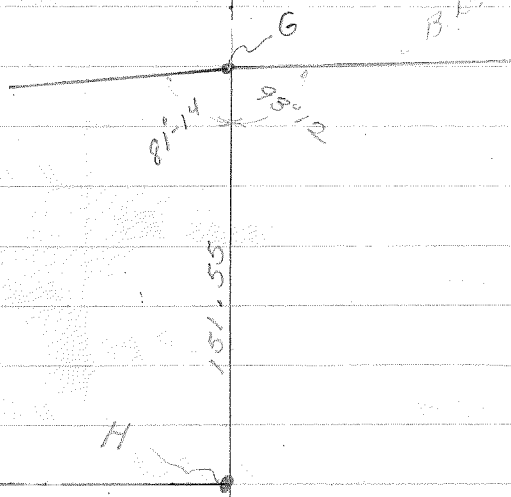

Pt	Dist	Defl. L	Cal. Bear
D			N 40-00 E
C	57.53	18-26 RT	N 21-40 E
S	47.51	0-38 RT	N 21-02 E
R	141.10	7-09 LT	N 28-11 E
Q	141.00	2-15 LT	N 30-27 E
P		14-30 LT	N 44-57 E
O	128.63	120-12 RT	N 75-15 W
N	100.88	5-47 RT	N 81-02 W
M	247.00	71-32 RT	S 27-26 W
L			

INDEXED ON MAP

128.63

INDEXED ON MAP



3956

INDEXED ON MAP
3956

14113
943
45.0

FB State Book 1

6

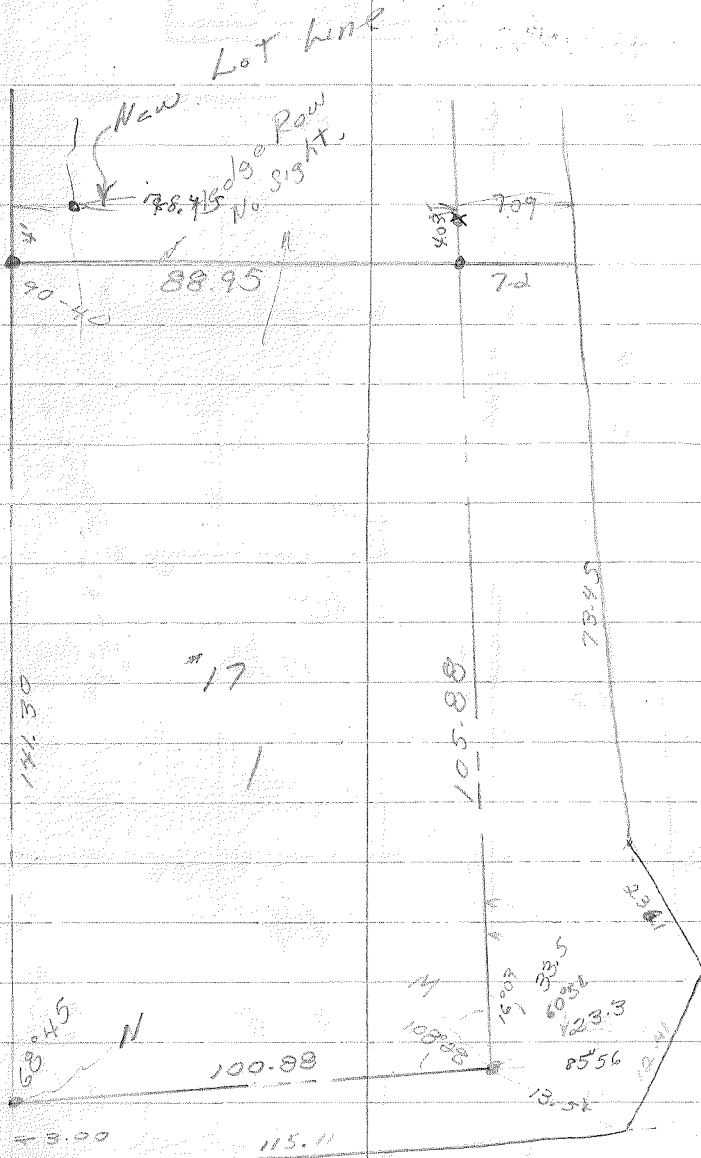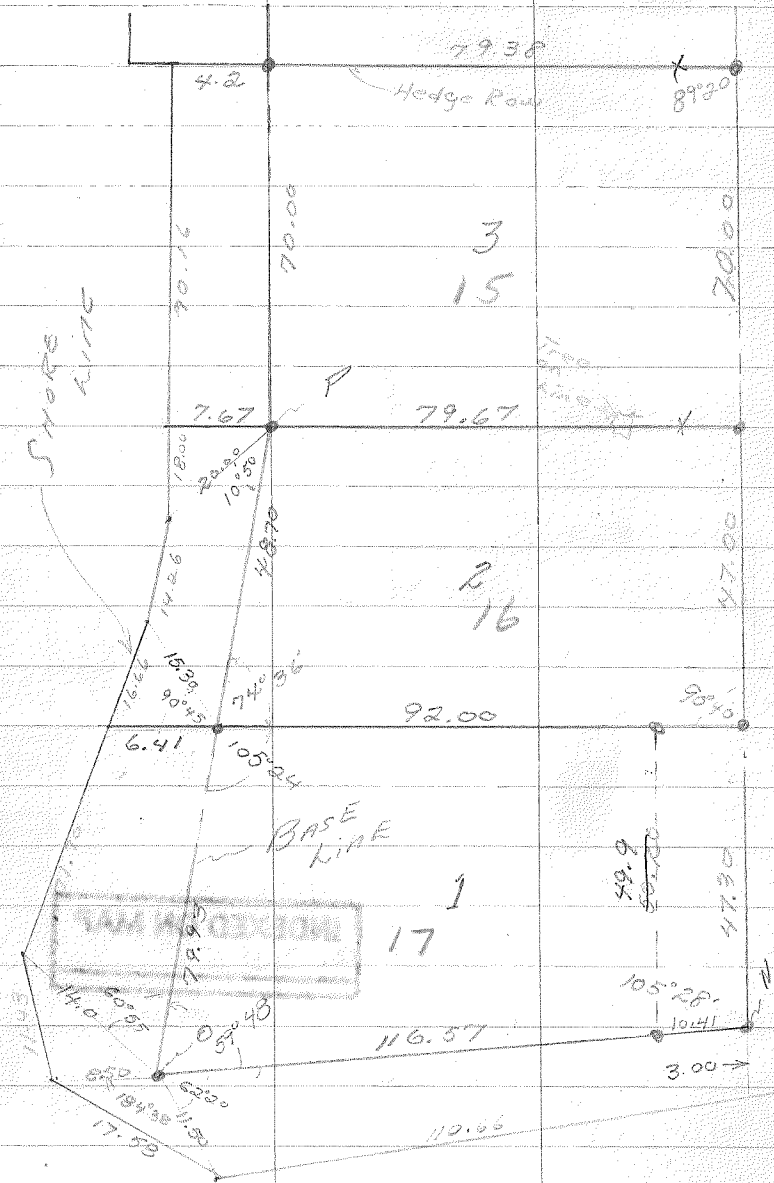



FB State Book 1

Same H.

INDEXED ON MAP

3956

7

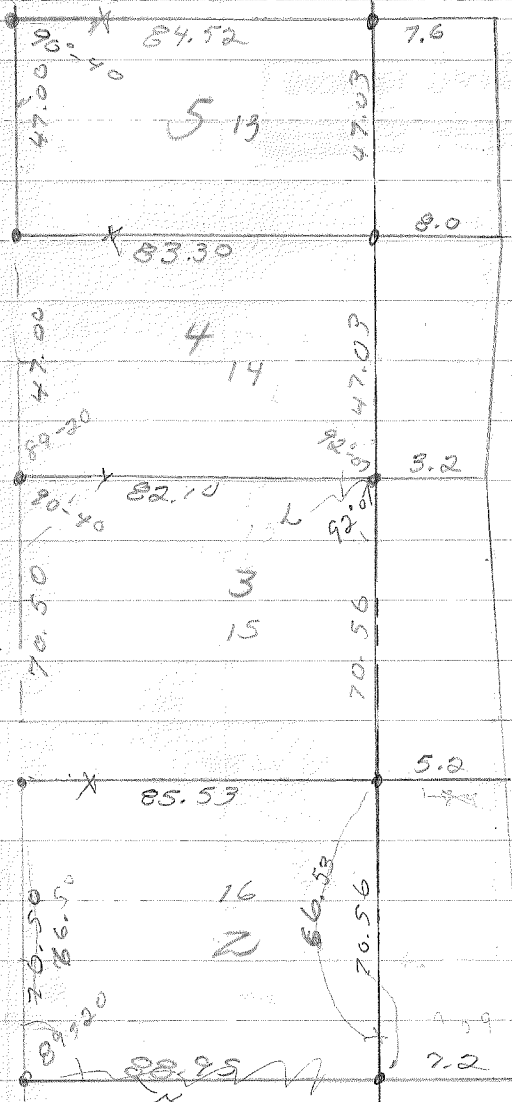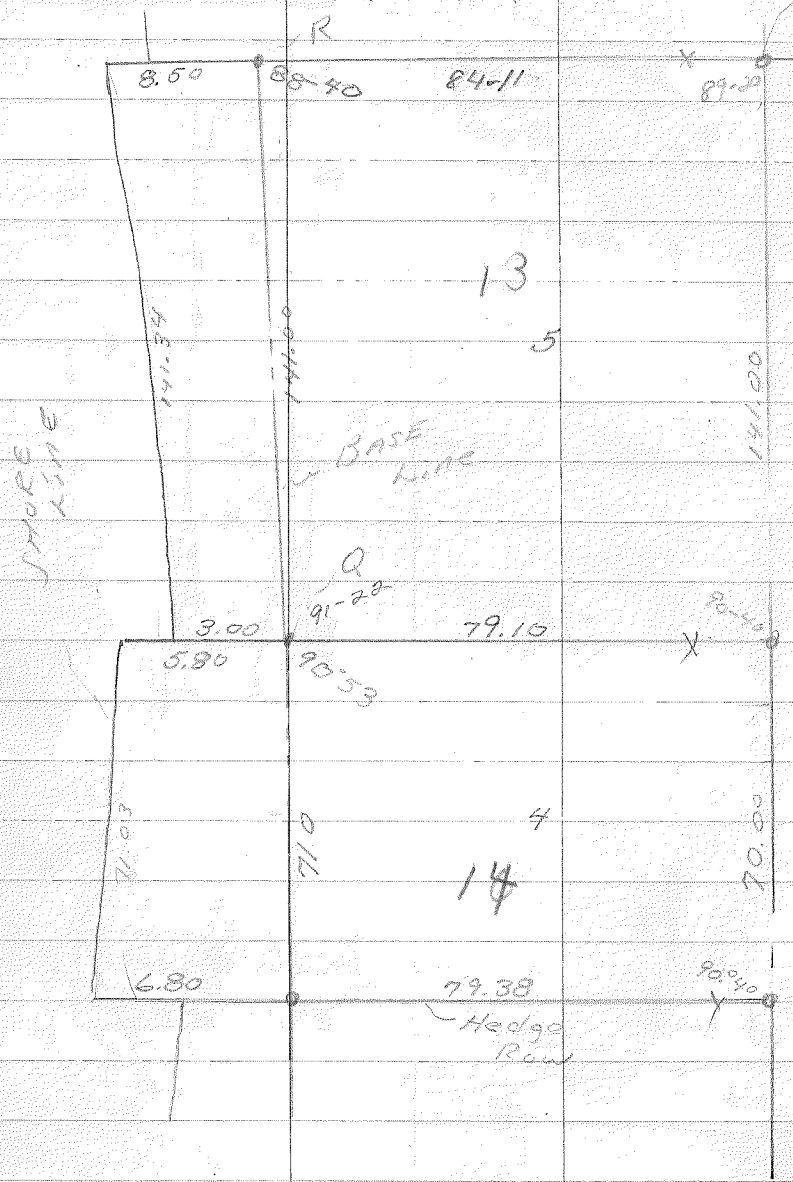

Hedge Row
No Sight



INDEXED ON MAP

FB State Book 1

P

INDEXED ON MAP

3956

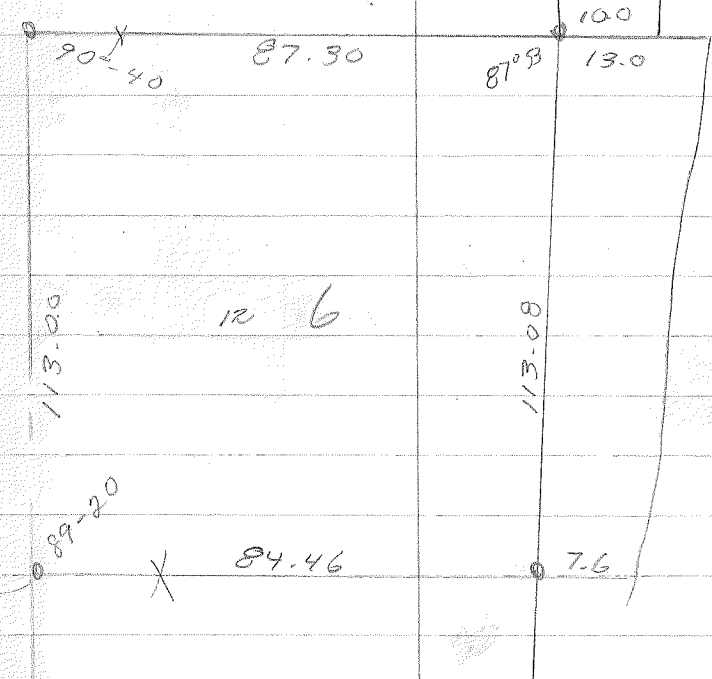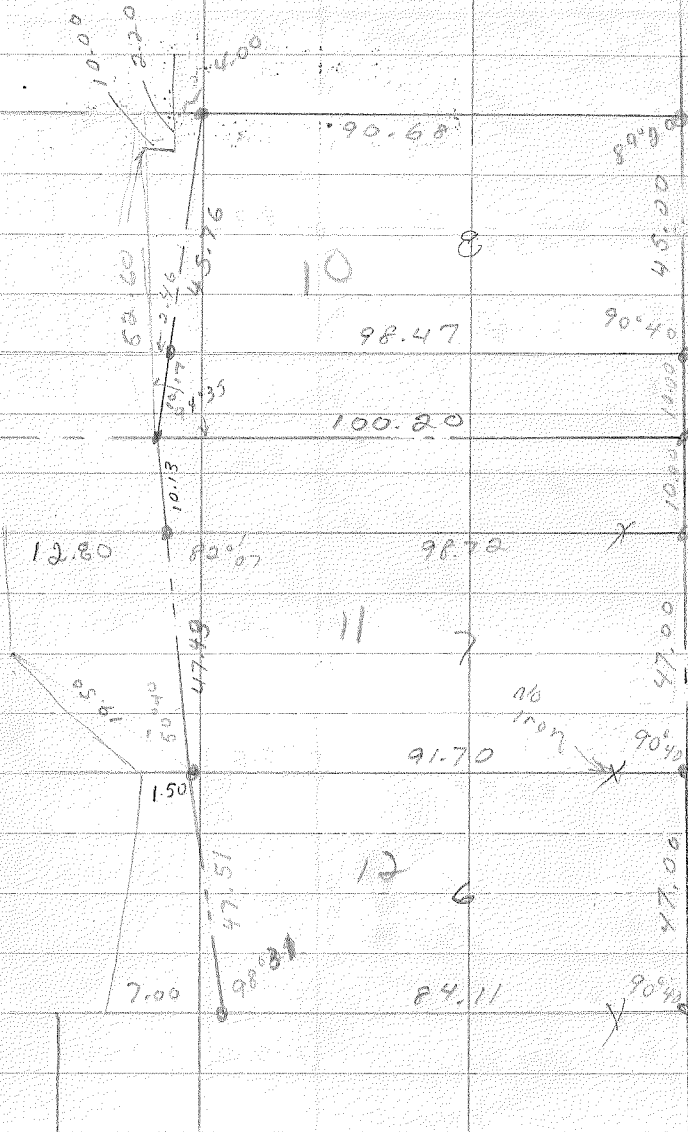

FB State Book 1

INDEXED ON MAP
3956

