



PART LOT 80
FIVE PARKS ALLOTMENT
WASHINGTON TOWNSHIP
October 31, 1977

The following described real estate situated in Washington Township, Logan County, Ohio and being part of Lot No.80 of Five Parks Allotment as shown and designated on Logan County Recorders Plat Book B, Volume 2, Page 122 and more particularly described as follows:

Commencing at an iron bar at the northwest corner of said lot 80; thence with the west line of said lot 80 S.10° 00'W. 60.04 feet to an iron bar, said iron bar being the beginning point of this description; thence continuing with said west line S.10° 00'W. 28.00 feet to the southwest corner of said lot; thence with the south line of said lot 80 S.80° 00'E. 27.00 feet to an iron bar; thence N.10° 00'E. 28.00 feet to an iron bar; thence N.80° 00'W. 27.00 feet to the place of beginning.

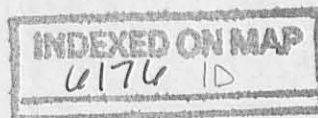

S.R. No. 366

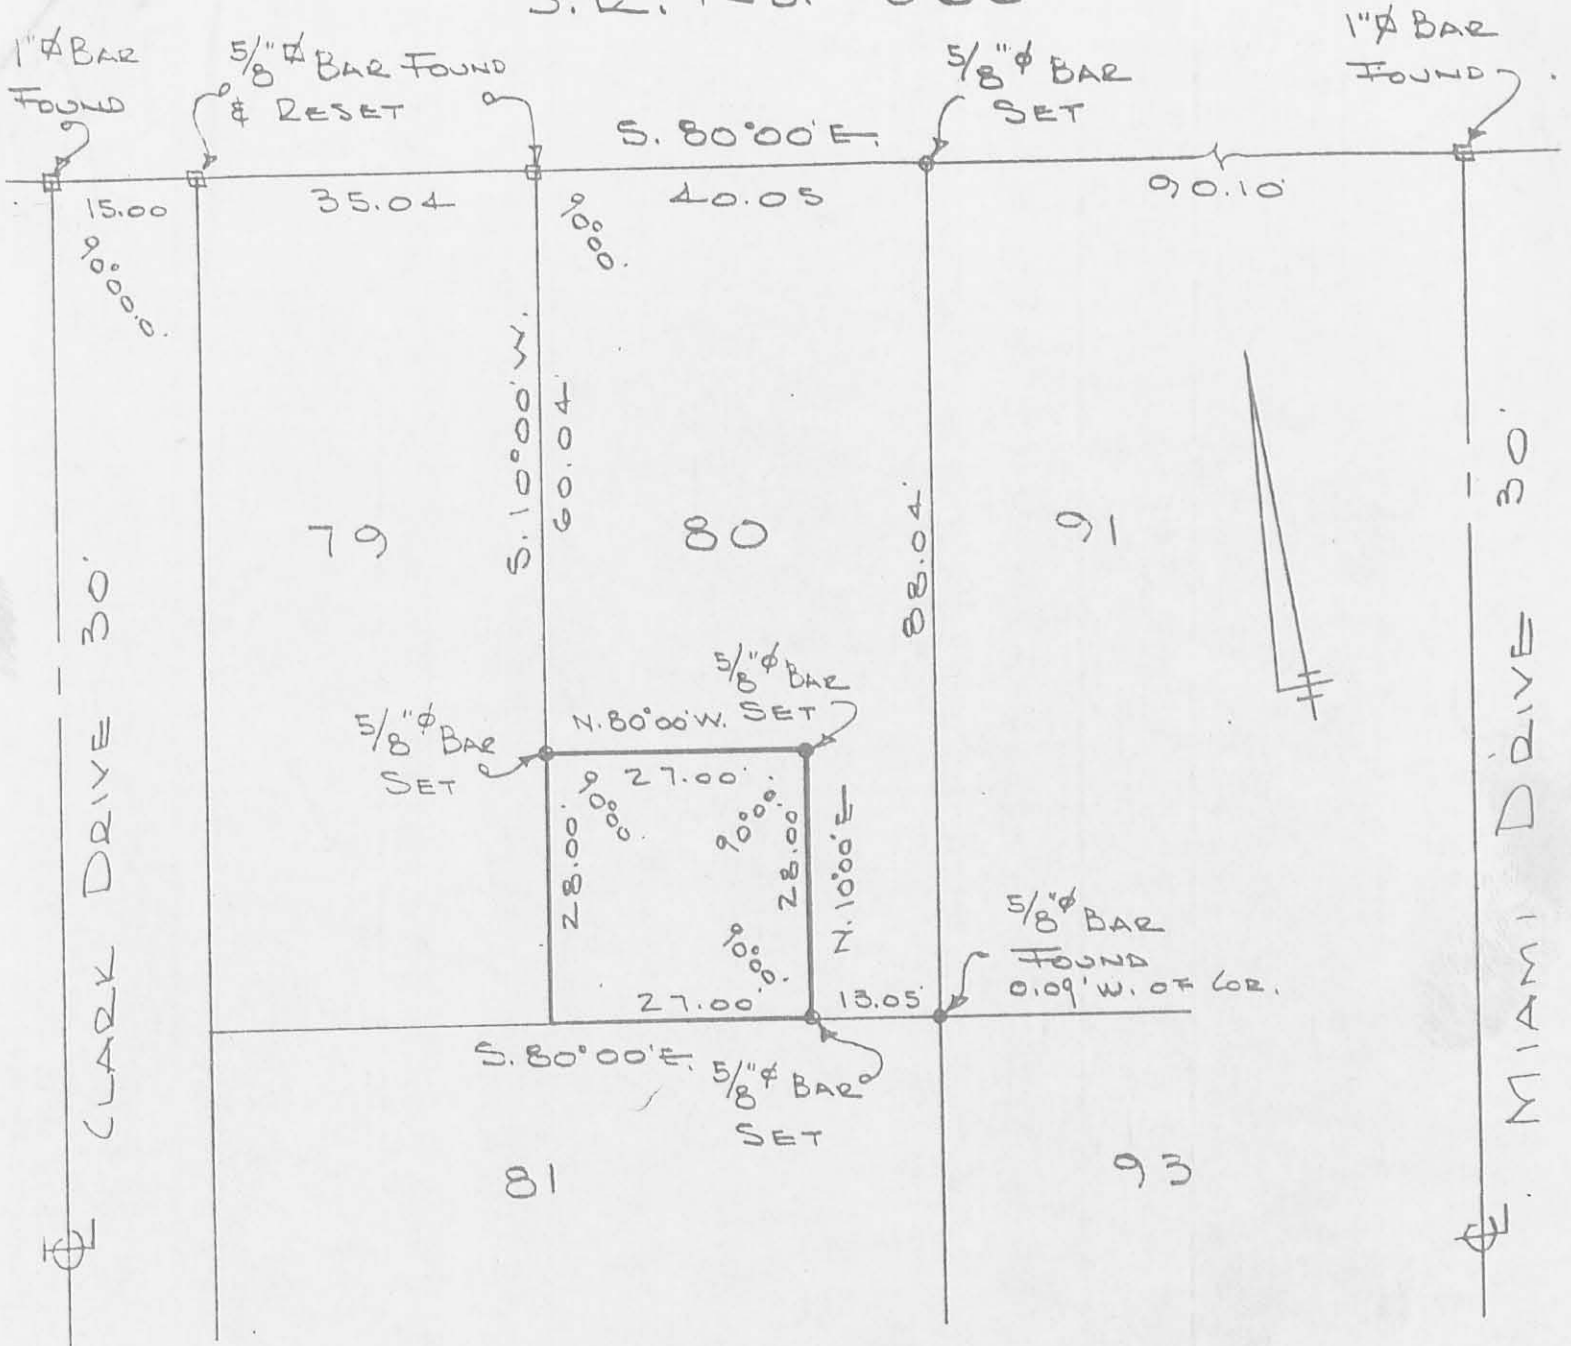

SURVEY OF

PART LOT NO. 80
 FIVE PARKS ALLOTMENT
 WASHINGTON TOWNSHIP
 LOGAN COUNTY, OHIO
 OCTOBER 31, 1977
 SCALE 1" = 20'

6176 1P

INDEXED ON MAP

DAN L. DODSON
 REG. SURVEYOR 4270
 BELLEFONTAINE, O.