
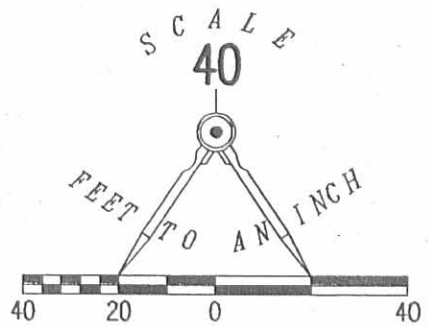


REV'D 3-28-08 SMYOK

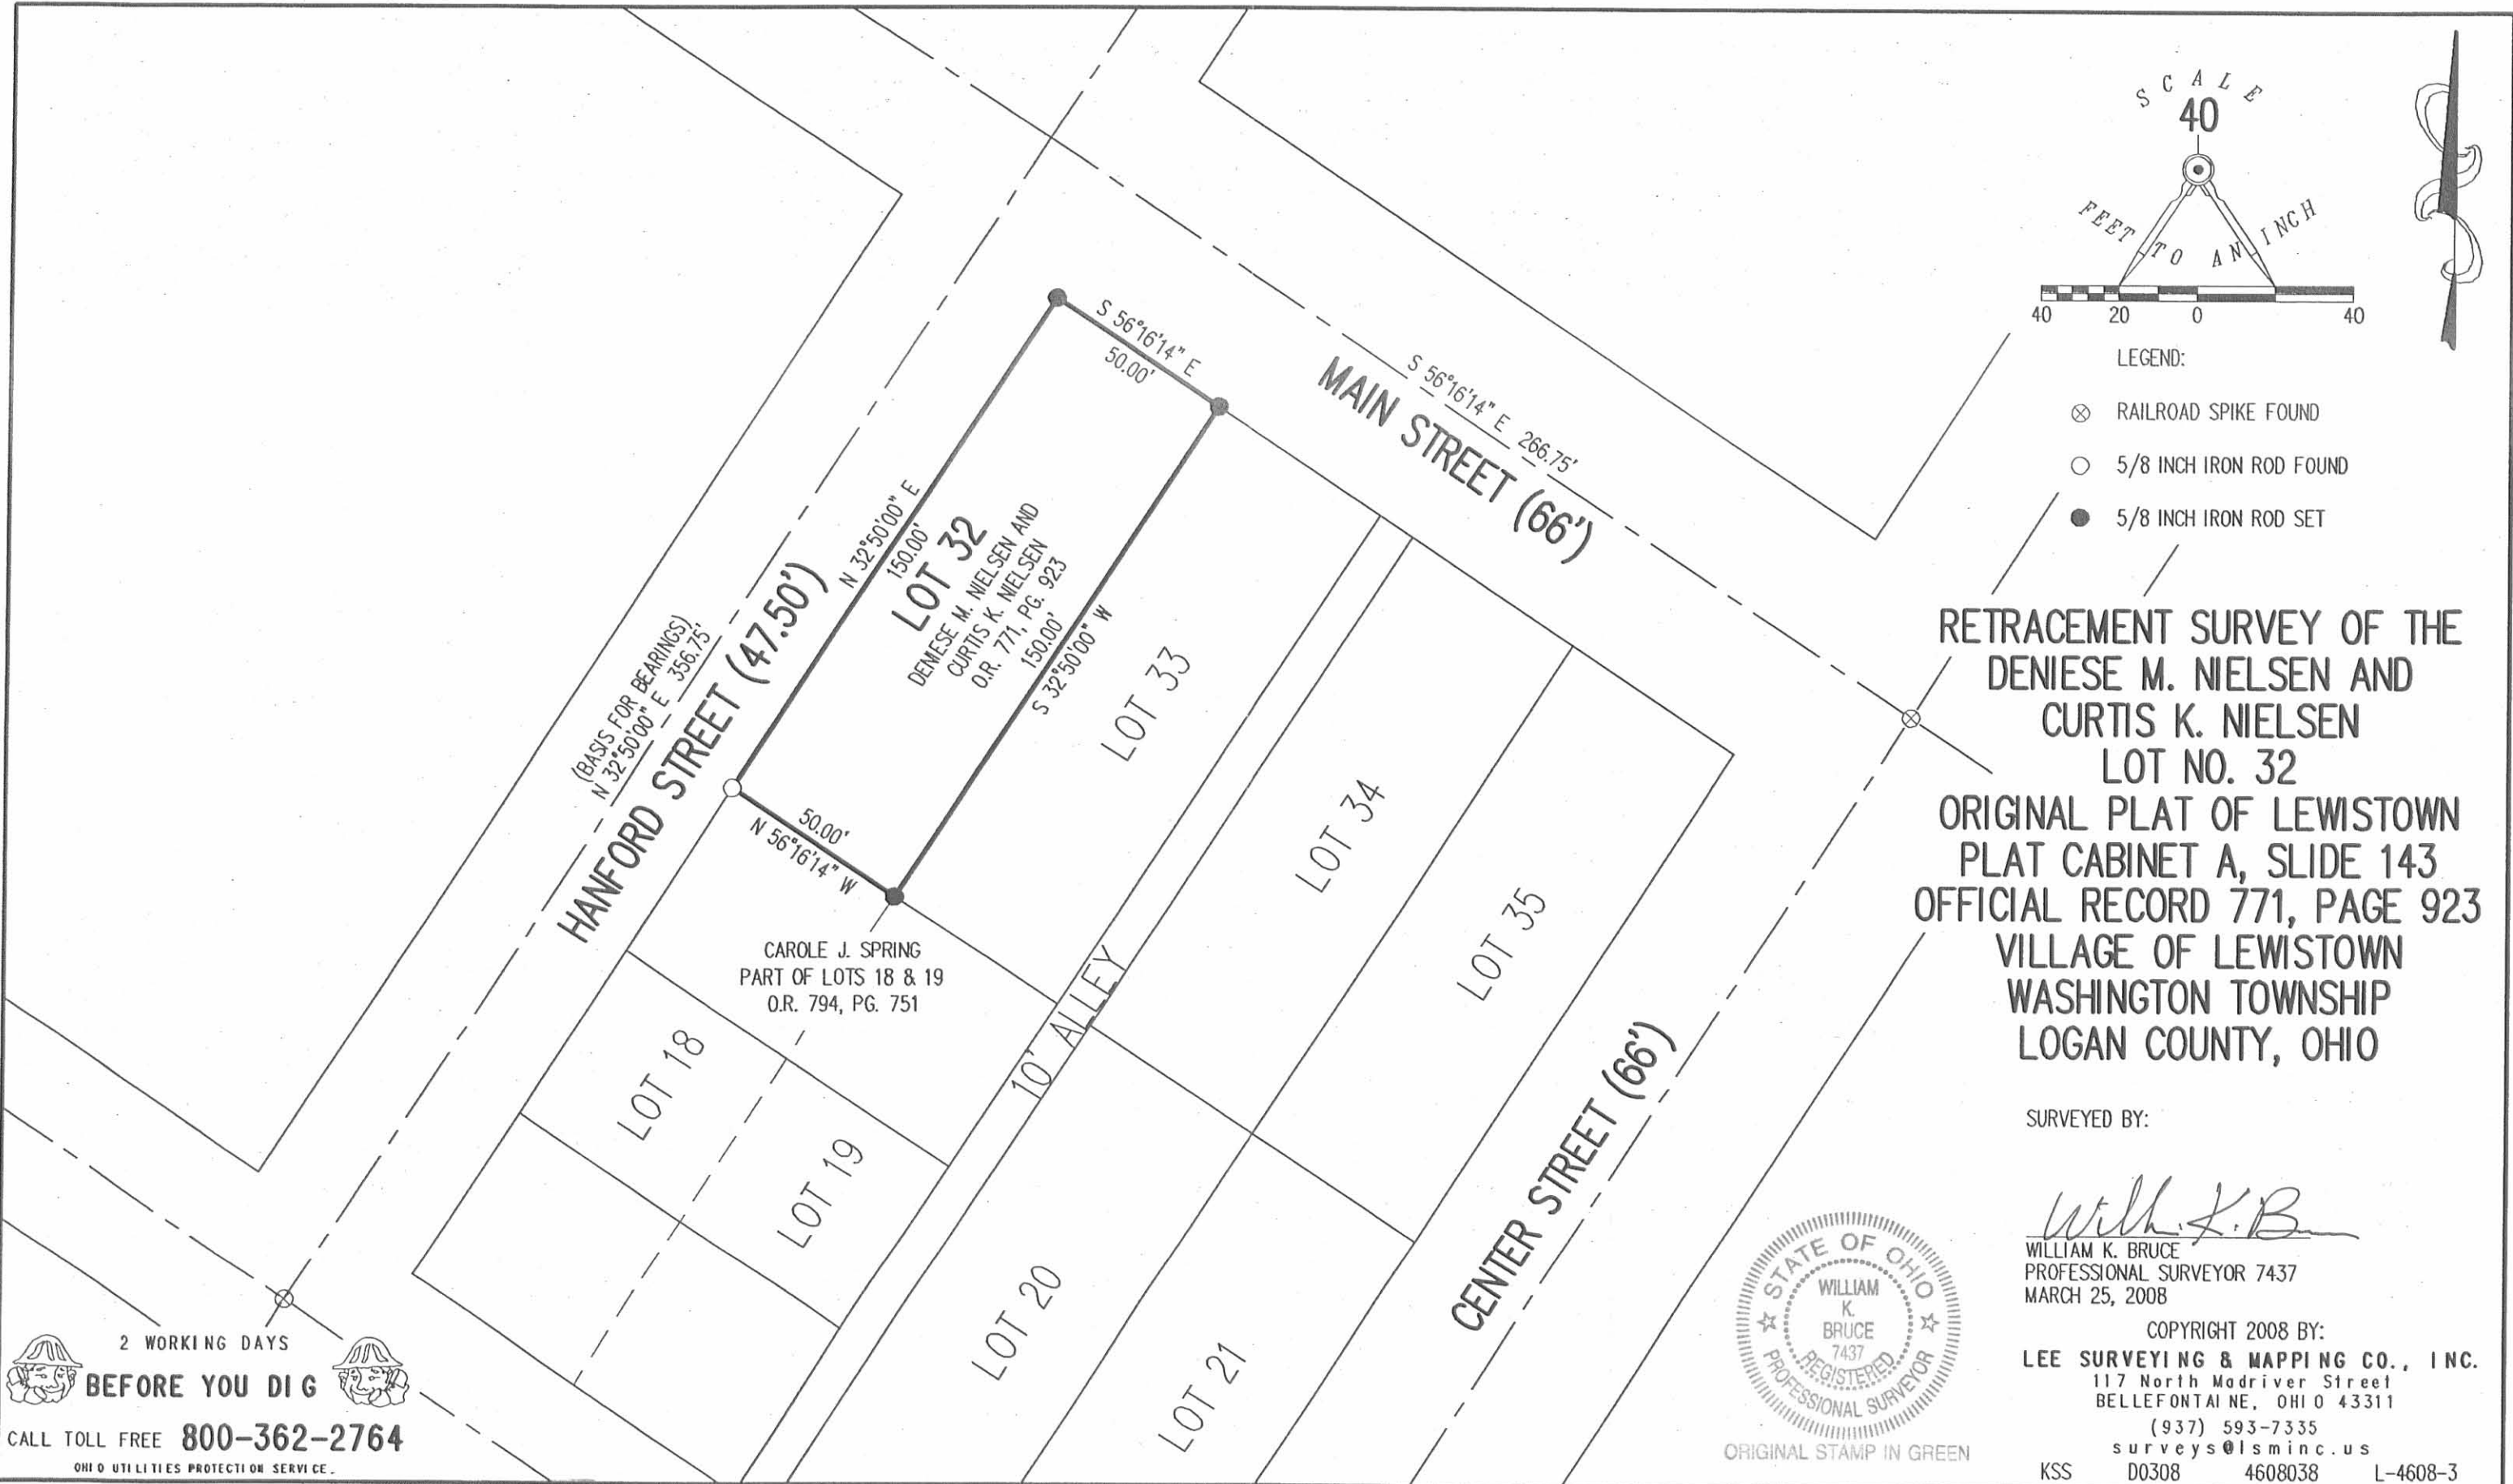

- LEGEND:
- ⊗ RAILROAD SPIKE FOUND
  - 5/8 INCH IRON ROD FOUND
  - 5/8 INCH IRON ROD SET

RETRACEMENT SURVEY OF THE  
DENESE M. NIELSEN AND  
CURTIS K. NIELSEN  
LOT NO. 32  
ORIGINAL PLAT OF LEWISTOWN  
PLAT CABINET A, SLIDE 143  
OFFICIAL RECORD 771, PAGE 923  
VILLAGE OF LEWISTOWN  
WASHINGTON TOWNSHIP  
LOGAN COUNTY, OHIO

SURVEYED BY:

*William K. Bruce*  
WILLIAM K. BRUCE

PROFESSIONAL SURVEYOR 7437  
MARCH 25, 2008



ORIGINAL STAMP IN GREEN

COPYRIGHT 2008 BY:  
LEE SURVEYING & MAPPING CO., INC.  
117 North Madriver Street  
BELLEFONTAINE, OHIO 43311  
(937) 593-7335  
surveys@lsmcinc.us  
KSS D0308 4608038 L-4608-3


2 WORKING DAYS  
**BEFORE YOU DIG**  
CALL TOLL FREE **800-362-2764**  
OHIO UTILITIES PROTECTION SERVICE

INDEXED ON MAP  
6548 1P


Albert Baker  
Lot 32, Lewistown Ohio

July 10, 1969

16

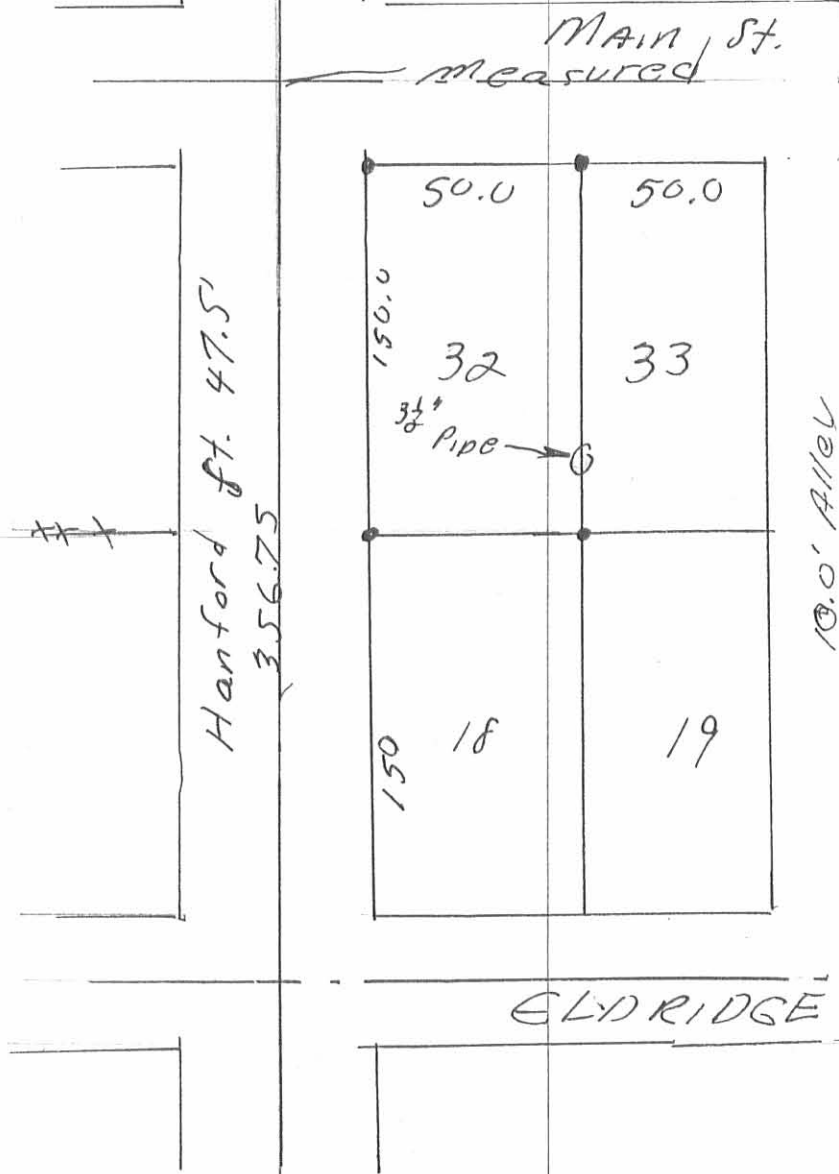

66.0'  
268.05

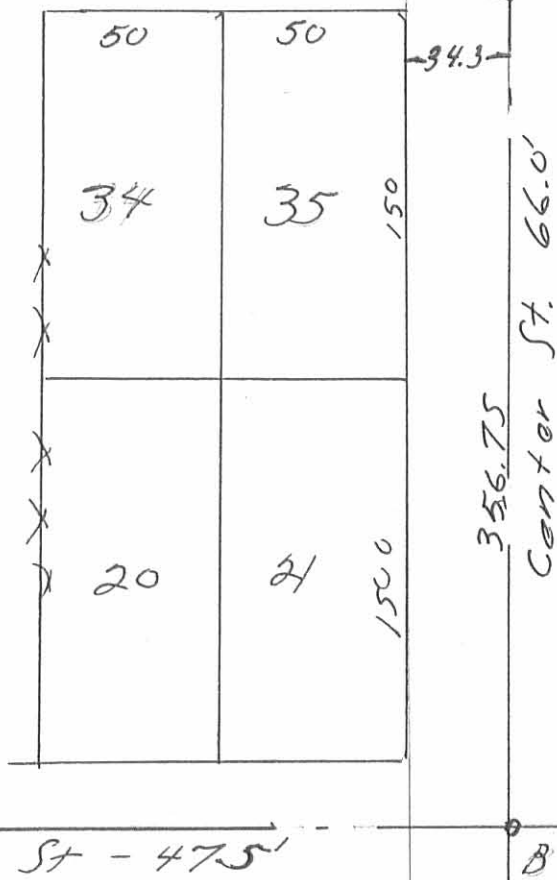

Found Irons at A & B  
but because of location of  
buildings & fence moved B  
1.3 feet west!

6548 2P