

PHONE 843-2041

HAROLD E. LORTON  
CIVIL ENGINEER AND SURVEYOR  
State Route 368  
9015 LAKERIDGE ROAD  
RTE. NO. 1 HUNTSVILLE, OHIO 43324



August 10, 1982

DEED DESCRIPTION FOR GEORGE WITENKO

Situated in the State of Ohio, County of Logan  
and in the Township of Washington, and in V.M.S. 9925.

Being part of Lot number 150 and 151 of Waterbury  
Subdivision and part of the lands adjacent to said lots  
conveyed by the Lake Lands Administrator to Clem J.  
Starvick by deed recorded in Volume 374, page 154 of the  
Deed Records of Logan County, Ohio.

Beginning at an iron pipe on the East line of  
Walnut Street, said iron pipe being 3 feet south of the  
Northwest corner of Lot number 151; thence on a line  
parallel with and 3 feet south of the north line of said  
lot and with the south line of the land conveyed by the  
Lake Lands Administrator to Clem J. Starvick S.65°49'57"E.  
139 feet to an iron pipe; thence N. 12°44'05"E. 7 feet to  
an iron pipe; thence N. 68°41'21"W. 137.66 feet to the  
Northwest corner of Lot number 151; thence with said north  
line in a southerly direction 3 feet to the place of  
beginning and containing 683.2 square feet.


Harold E. Lorton  
9015 State Route 368  
Huntsville, Ohio 43324  
Registered Surveyor #2913

6770 1D

INDEXED ON MAP

PROPERTY SURVEY  
FOR  
GEORGE & VIRGINIA WITENKO  
WALNUT STREET

Being part of Lot number 150 and 151 of Waterbury  
Subdivision and part of 151A of the LAKE LAND AGREEMENT.  
Situated in the State of Ohio, County of Logan in  
the Township of Washington and in V.M.S. 9925.

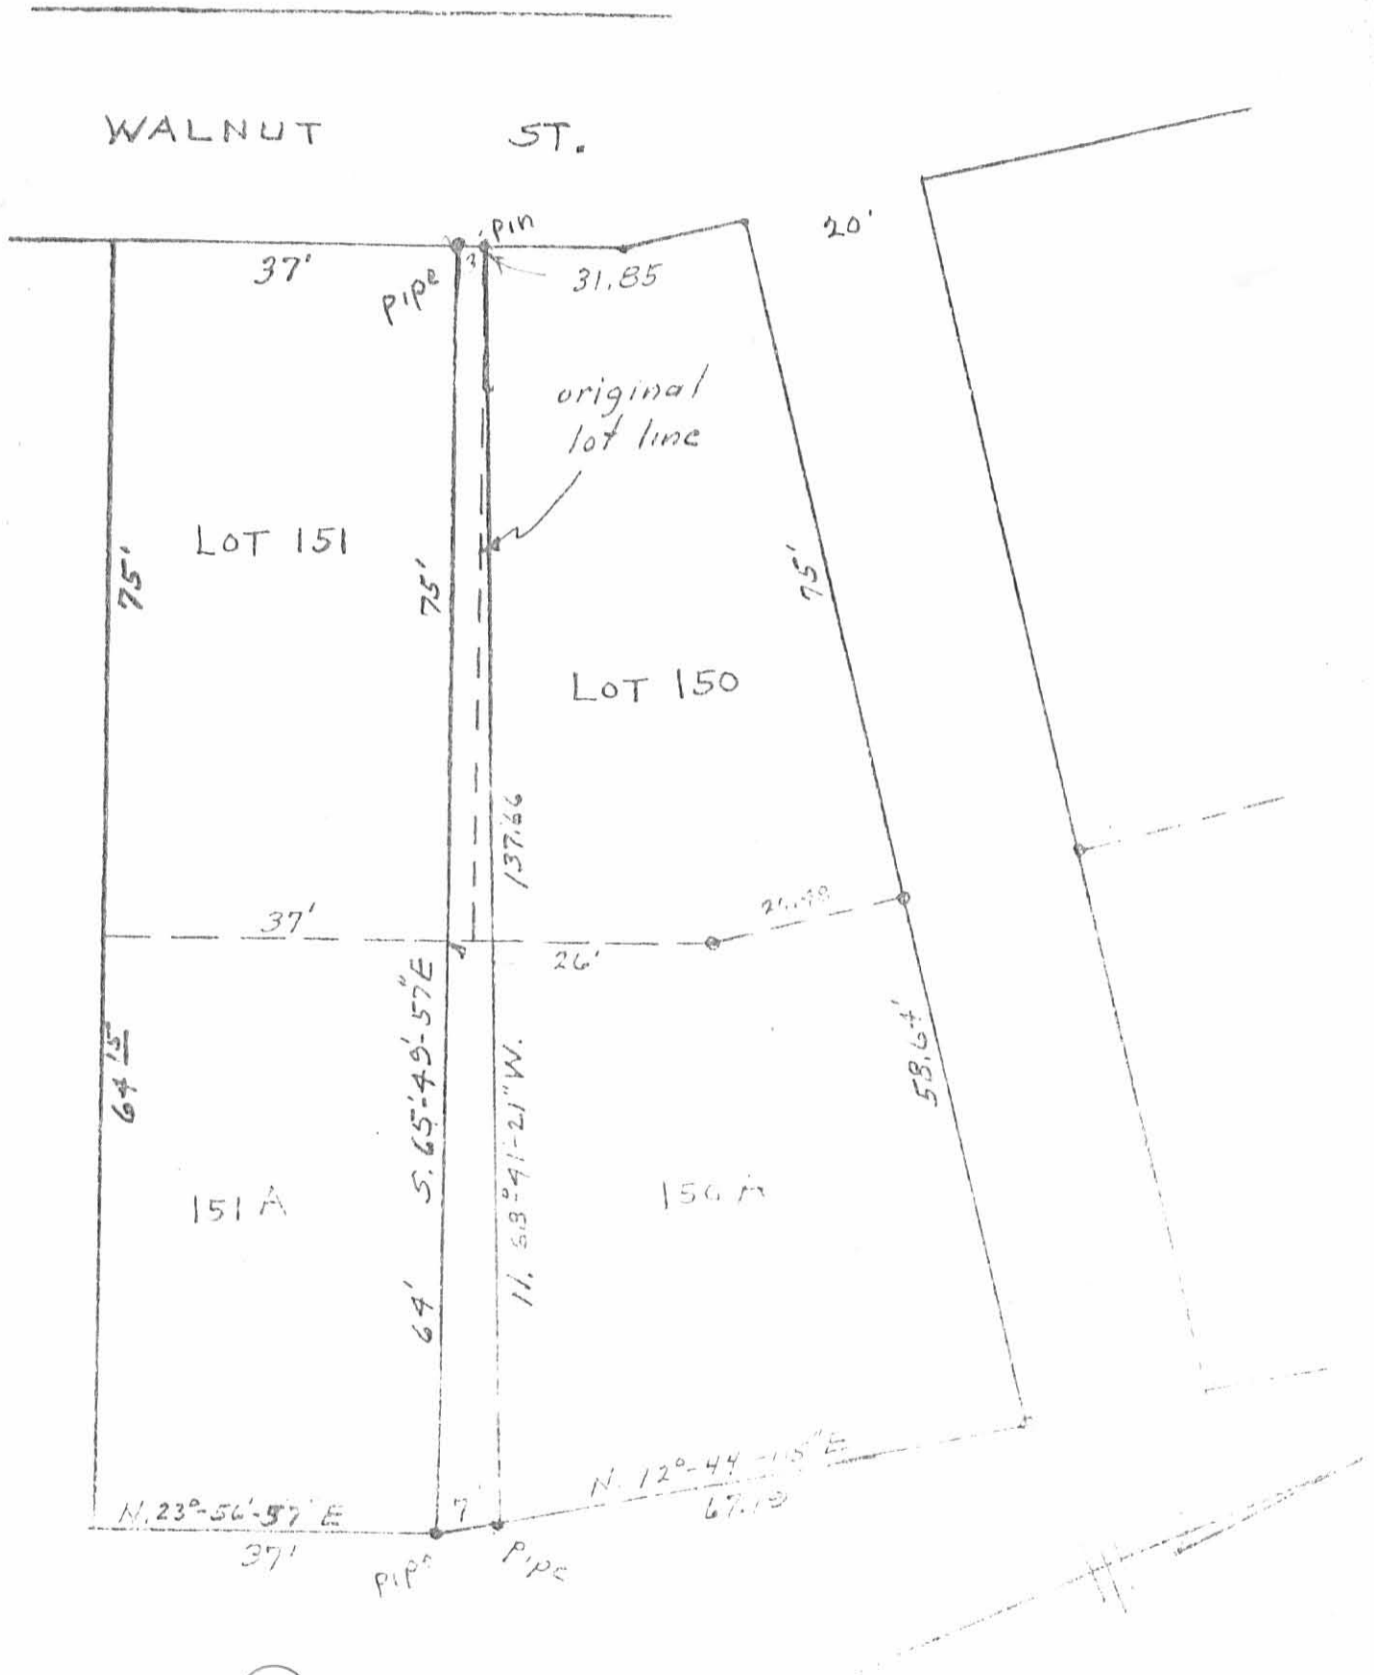

(6770) IP

INDEXED ON MAP

Scale: - 1" = 20'

August 9, 1982

Harold E. Lorton  
9015 State Route 368  
Huntsville, Ohio 43324  
Registered Surveyor #2913