


INDIAN DRIVE

40' WIDE

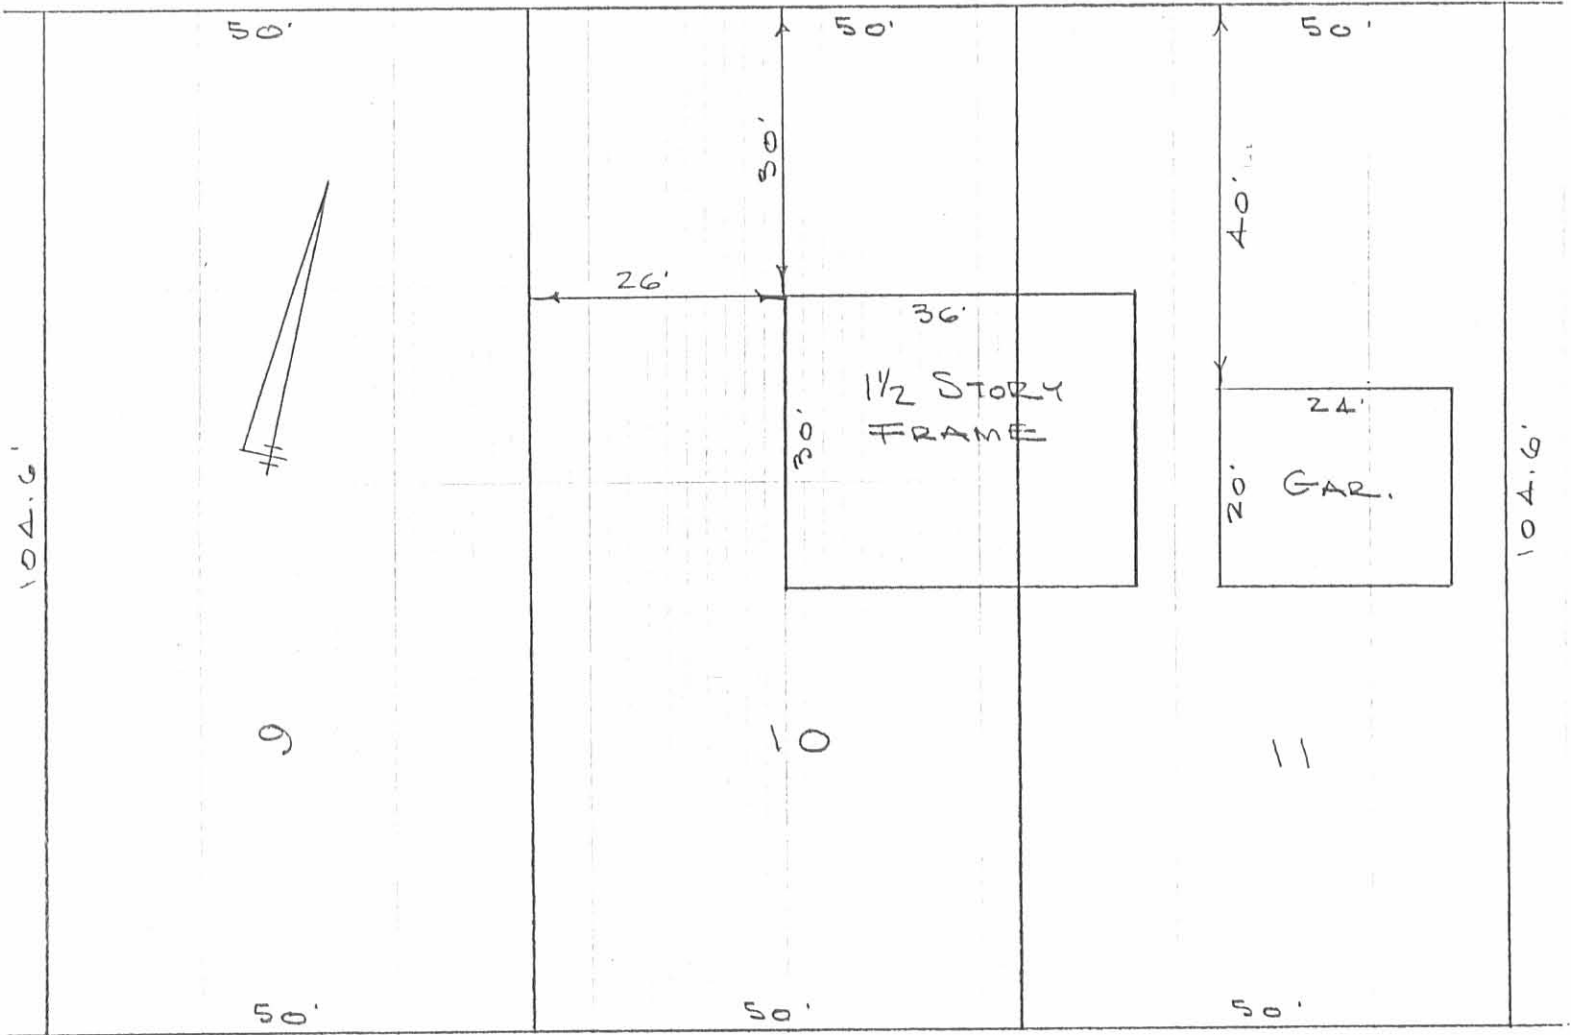

LOTS 9-10-11
BERGS ALLOTMENT
V.M.S. 9925-9946-10121.
WASHINGTON TOWNSHIP
LOGAN COUNTY, OHIO
FEB. 17, 1973
SCALE 1" = 20'

I HEREBY CERTIFY THAT I HAVE
INSPECTED THE ABOVE LOTS AND
FOUND THE BUILDINGS TO BE
LOCATED AS INDICATED.

Dan L. Dodson

DAN L. DODSON
REG. SURVEYOR 4270
BELLEFONTAINE, OHIO

INDEXED ON MAP
0703 IP

1 Received 6-23-92

OR 6-24-92 c.e

LESLIE H. GEESLIN
REGISTERED SURVEYOR NO. 5248
P. O. BOX 274
RUSHSVLVANIA, OHIO 43347

TELEPHONE: (513) 468-2793

ARCHER SURVEY

June 19, 1992

The following described real estate situated in the State of Ohio, County of Logan, Township of Washington, being part of Lot 6 of Bergs Allotment as shown in the Logan County Recorder's Plat Cabinet "A" Slide 164 and more particularly described as follows:

Beginning at a 5/8 inch iron bar set in the south right-of-way line of Indian Drive at the northwest corner of Lot 7 of said Allotment, said iron bar being S. 75° 00' 00" w. 100.00 feet from a 2 inch iron pipe found at the northeast corner of Lot 8 of said Allotment.

Thence with the west line of said Lot 7 S. 15° 00' 00" E. 103.60 feet to a power pole found at the southeast corner of Lot 6 of said Allotment.

Thence with the south line of said Lot 6 S. 74° 42' 49" W. 30.00 feet to a 5/8 inch iron bar set.

Thence N. 15° 00' 00" W. 103.75 feet to a 5/8 inch iron bar set in the south right-of-way line of Indian Drive and the north line of said Lot 6.

Thence with said right-of-way line and north line N. 75°00'00"E. 30.00 feet to the place of beginning.

Containing 0.071 acre more or less.


the above described 0.071 acre tract being a 30 foot strip off the east side of Lot 6 as described in *D.B.* Vol. 282 Page 95.

Bearings are based on an assumed bearing (N. 15° 00' 00" E.) for the south right-of-way line of Indian Drive in this field survey done by Leslie H. Geeslin, Reg Surveyor 5248 on June 19, 1992.



Leslie H. Geeslin

INDEXED ON MAP
8703 2D

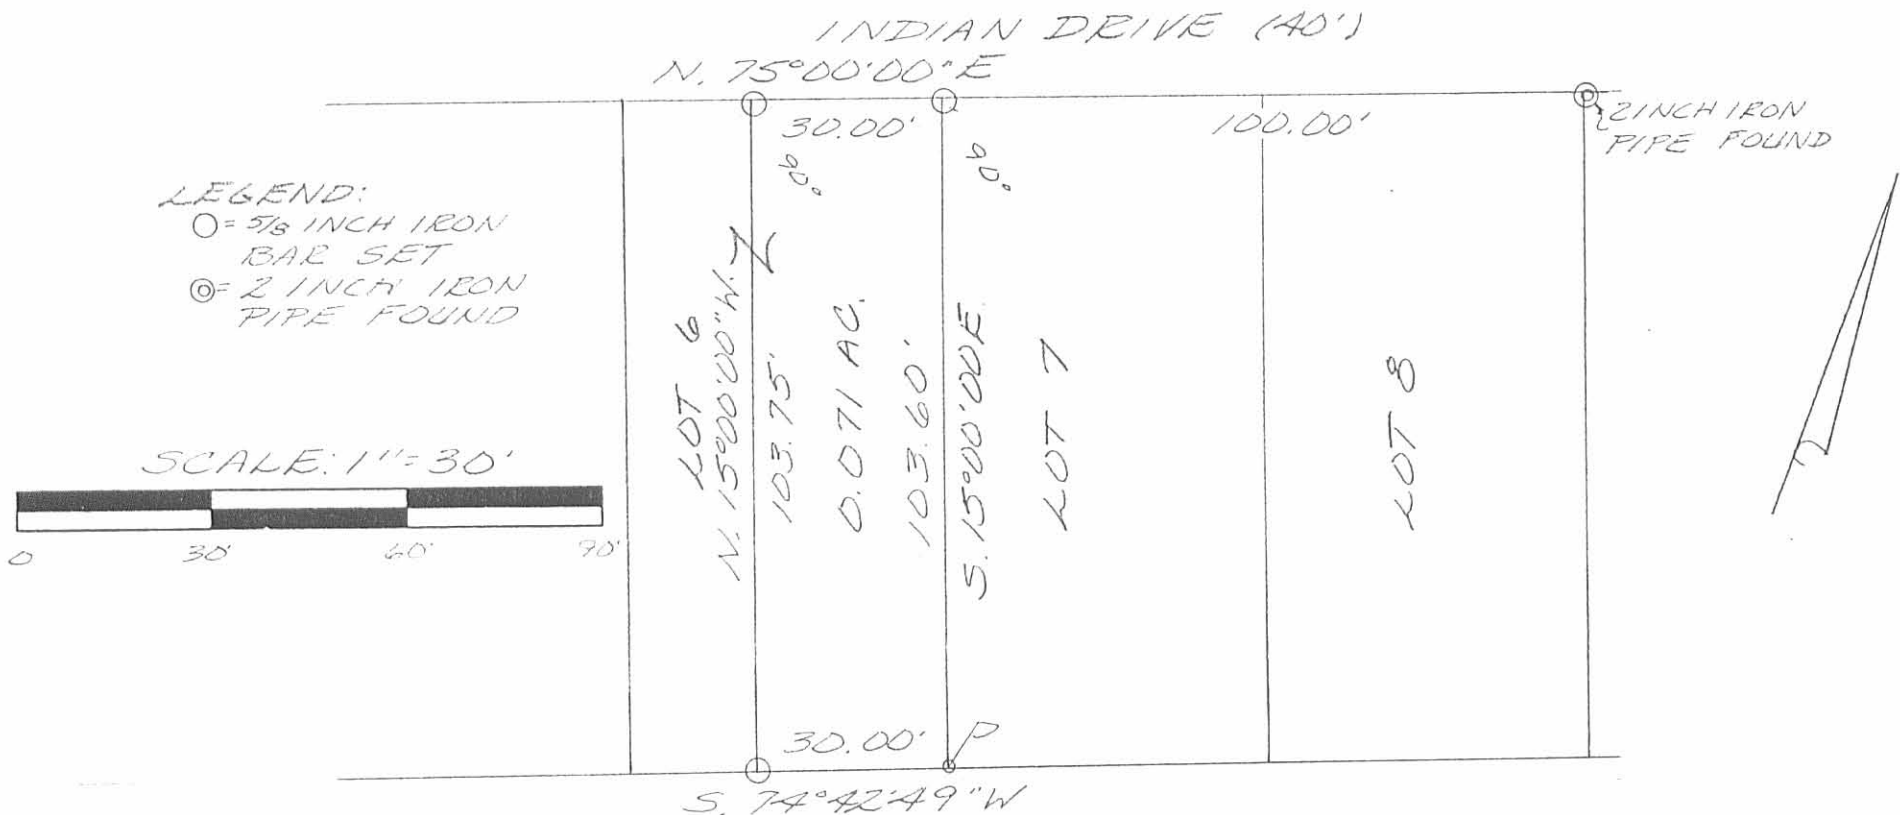

SURVEY OF A 30' STRIP ON THE EAST SIDE OF LOT 6 OF BERGS ALLOT. IN WASHINGTON TOWNSHIP, LOGAN COUNTY, OHIO AS RECORDED IN THE LOGAN COUNTY RECORDER'S PLAT CABINET "A" SLIDE 164 TO RICK ARCHER
 JUNE 18, 1992



Leslie H. Geeslin

INDEXED ON MAP
 8703 28

LESLIE H. GEESLIN
 BUSHYLANDIA, OH
 (513) 468-2793