


Park West Liberty
 Bailey Land
 sec-29 T.5 R.13

(1833)
 INDEXED ON MAP

Jan 9, 1935
 Work on
 Park West
 Liberty
 Frank Irvine

45

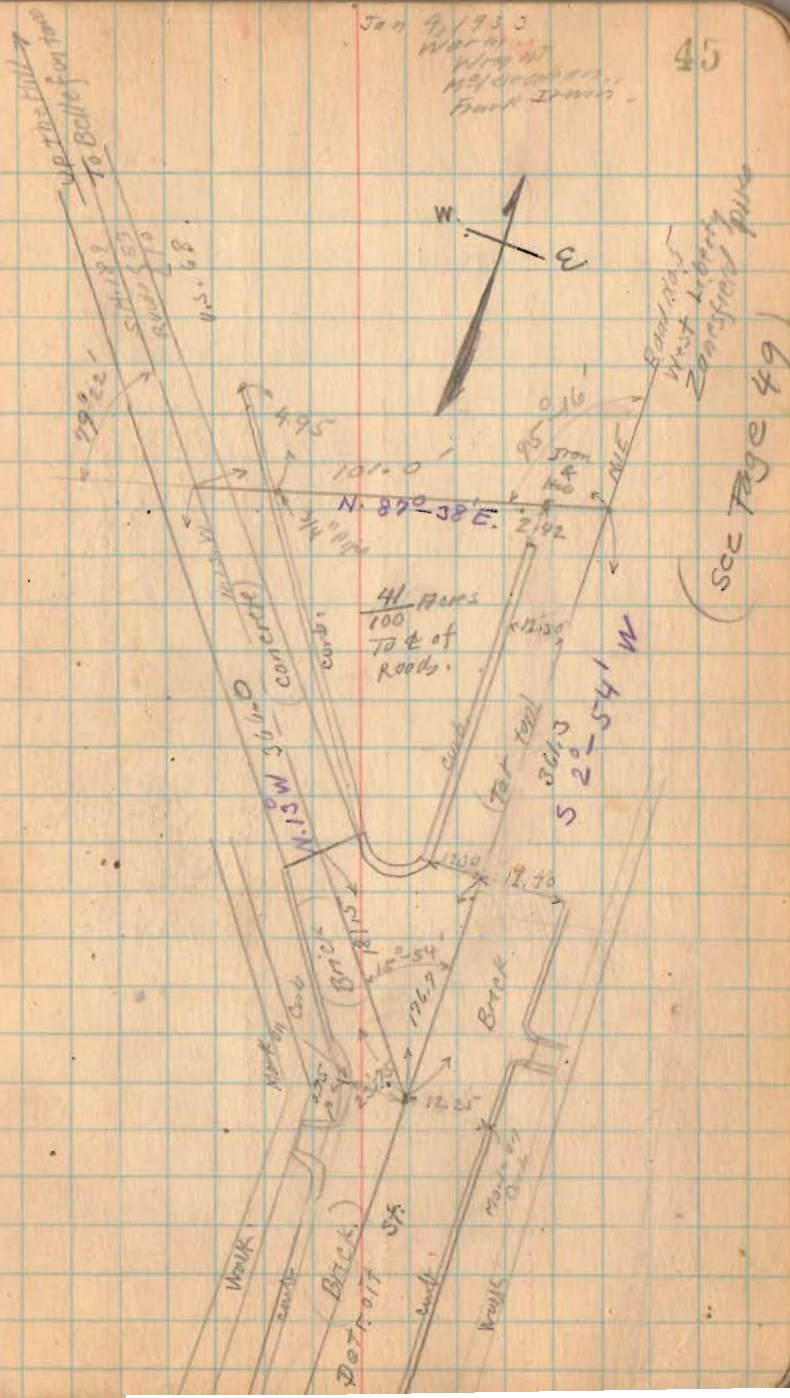

1933

Bailey Park Survey - West Liberty

The following described land in Sec. 27, T.5, R.13, of
The Miami River Survey and being in West Liberty Township, Logan
County, Ohio.

Beginning at a chisel mark in the brick pavement where
the center of State road No.189 intersects the center of Detroit
Street, thence N.13°-0' W. with the center of State road No.189
(also known as Bellefontaine - West Liberty Pike and being State
Route 53 and 10) 363.0 feet to a chisel mark in the concrete, the
last described line passing the end of the brick pavement and the
beginning of the concrete pavement at 181.5 feet, thence N.87°-38'
E. 101.0 feet to the center of County road No.5 (also known as
West Liberty - Zanesfield - Rushsylvania Pike or Detroit Street of
West Liberty) thence S.2° - 54' W. with the center of said road
No.5, 361.3 feet to the place of beginning the last described line
passing the beginning of the brick pavement at 184.6 feet, said
tract containing .41 of one acre and being the same tract as surveyed
Jan.4, 1932 as shown and recorded in Logan County Surveyor's Book
No. 509, Page 45.

INDEXED ON MAP

1433 ID