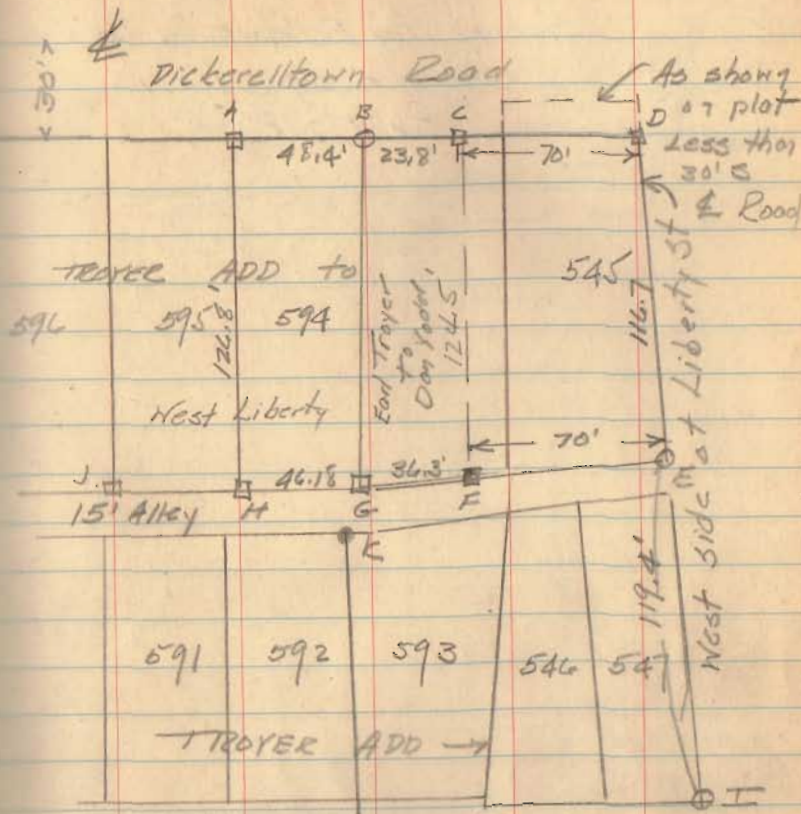


42

See Book 11 Page 86

Survey of Lot 594
and part of 527, T5, R13
MRS in West Liberty Ohio
for
EARL TROYER

- A stake (set) on S. side Pickersill town Road 48.4' west of B in line with lot stakes to west (found)
- B $\frac{3}{4}$ " iron pipe (found) NE cor Lot 594
- C 2"x2" stake (set) in line with AB 70' west of west line Liberty
- D 2"x2" stake (set) at intersection of AC and E1
- E Pipe (found) SE corner Lot 545
- F $\frac{3}{4}$ " bar (set) on line GE 70' west of E (west line Liberty)
- G 2"x2" stake (set) SE cor Lot 594 46.18' E of J and on line with lot stakes to west.
- H 2"x2" stake set SW cor Lot 594 on line with stakes to west and 50' E of J,
- I iron pipe (found) SE cor Lot 547

5-7-49 CAHskoop
FM Miller 43

- J. stake (found) SW cor Lot 595 in line with lot stakes to west
- K $\frac{3}{4}$ " iron bar (found) NE cor Lot 592

2362

INDEXED ON MAP